

Ya300  
U51  
10-68  
Elec Log

MISSISSIPPI  
BOARD OF WATER COMMISSIONERS  
416 North State Street  
Jackson, Mississippi 39201

CODED

CODE

WATER WELL DRILLERS LOG

10-12 1968 McCannell Drilling Ya200  
date well completed firm name county well located

LANDOWNER:  
Dixie farms  
River St. Sataritia Miss  
(mailing address)

description of formations encountered	from	to
silt & clay	0	40
sand & Gravel	40	140
Gumbo	140	465
sand & shale	465	473
Sand.	473	478
shale.	478	480
sand.	480	495
sand & shale.	495	520
Sand.	520	580
sq shale	580	615
shale.	615	680
sand.	680	686
sq shale	686	700
Sand. Cond.	700	792
shale.	792	798
Sand.	798	810
sq shale.	810	900
Hard shale.	900	911
sq shale.	911	940
Shale.	940	963
Hard sq shale	963	995
Hard sq & lime st.	995	1020
sq shale.	1020	1069

WELL LOCATION:  
sec. 6 T. 9 N. R. 4 W.  
6 miles W of Sataritia  
(distance) (direction) (nearest town)

WELL PURPOSE:  
(home, irrigation, municipal, industrial)


WELL COMPLETION DATA:  
(1) diameter (inches) 4 x 2 1/2  
(2) total depth (feet) 1069  
(3) static water level (feet) 2' below top of ground.  
(4) casing steel, 1069,  
(material) (depth)  
4 x 2 1/2 If telescope see back.  
(size)  
(5) screen 35, 759  
(length) (depth to top)  
2 1/2, st. steel  
(size) (material)  
(6) pump 3, 78  
(HP) (yield gpm)  
Elect.  
(type power)  
(7) electric log Yes  
(yes or no)  
Miss G. S.  
(organization running log)  
(8) how well bottom plugged  
Back wash valve.

DRILLERS REMARKS:


CODED

If well telescopes please sketch and show depths.

GROUND LEVEL

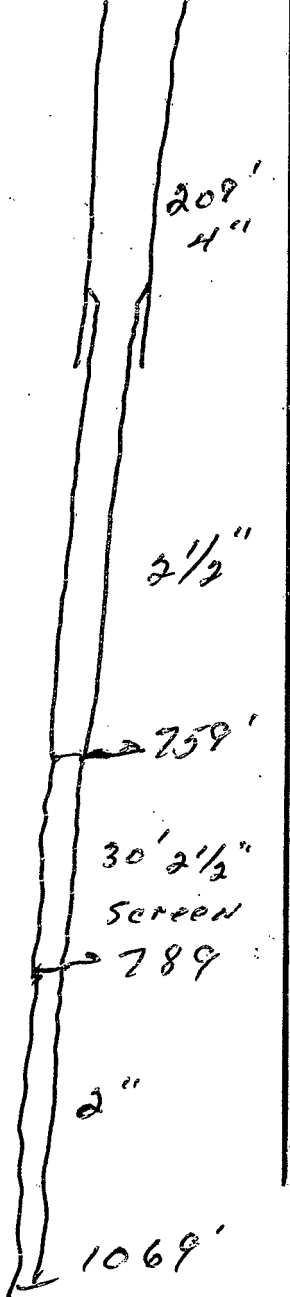

If more than one screen, show locations of each on sketch.

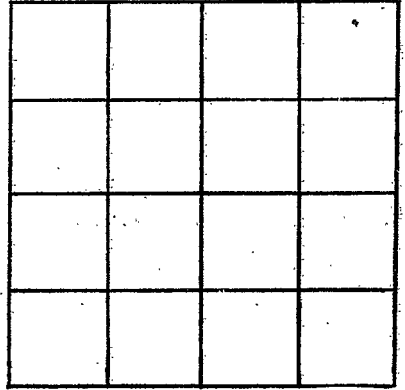

SECTION \_\_\_\_\_

Please indicate well location X.

ADDITIONAL INFORMATION

A series of horizontal lines for providing additional information.