

YAZOO  
U 52  
5-8-79

MISSISSIPPI  
BOARD OF WATER COMMISSIONERS  
416 North State Street  
Jackson, Mississippi 39201

CODED

WATER WELL DRILLERS LOG

5/8 1979 E.M. "Bud" CRESSWELL YAZOO  
date well completed firm name county well located

LANDOWNER:  
Dixie Farms  
SARTORIA, MS.  
(mailing address)

description of formations encountered	from	to
	Clay	0
Sandy gravel	45	110
Clay	110	420
Sandy shale	420	560
Sand	560	660

WELL LOCATION:  
sec 5 T 9 N R 4 E  
3 miles South of SARTORIA  
(distance) (direction) (nearest town)

WELL PURPOSE: Farm  
(home, irrigation, municipal, industrial)

WELL COMPLETION DATA:

(1) diameter (inches) 4

(2) total depth (feet) 660

(3) static water level (feet) 0 below top of ground.

(4) casing PVC 620  
(material) (depth)

4 (size) If telescope see back.

(5) screen 40 620  
(length) (depth to top)

2 PVC  
(size) (material)

(6) pump 1 1/2 35  
(HP) (yield gpm)

(type power)

(7) electric log no  
(yes or no)

0  
(organization running log)

(8) how well bottom plugged  
Steel plug

CODED

Miss. Board of Water Comm.


MAY 24 1979

RECEIVED

DRILLERS REMARKS:

If well telescopes please sketch and show depths.

GROUND LEVEL

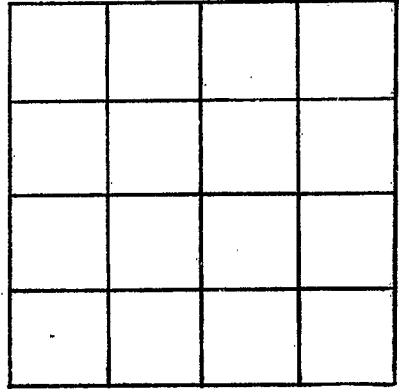

SECTION \_\_\_\_\_

Please indicate well location X.

ADDITIONAL INFORMATION

If more than one screen,  
show locations of each on sketch.