

YAZOO
U 53
5-4-79

MISSISSIPPI
BOARD OF WATER COMMISSIONERS CODED
416 North State Street
Jackson, Mississippi 39201

WATER WELL DRILLERS LOG

5/4 1979 E.M. "Bud" CRESSWELL YAZOO
date well completed firm name county well located

| LANDOWNER: | description of formations encountered | from | to |
|--|---------------------------------------|------|-----|
| (mailing address) | | | |
| Dixie Farms | Clay | 0 | 30 |
| Spartia, MS. | Sand & gravel | 30 | 120 |
| | Clay | 120 | 400 |
| | Dark shale | 400 | 460 |
| | Sand | 460 | 640 |
| WELL LOCATION: | | | |
| sec. 5 T. 9 N. R. 4 E. S. 3 | | | |
| 3 miles South of Spartia | | | |
| (distance) (direction) (nearest town) | | | |
| WELL PURPOSE: FARM | | | |
| (home, irrigation, municipal, industrial) | | | |
| WELL COMPLETION DATA: | | | |
| (1) diameter (inches) 4 | | | |
| (2) total depth (feet) 640 | | | |
| (3) static water level (feet) 0 below top of ground. | | | |
| (4) casing PVC 600 (material) (depth) | | | |
| 4 (size) If telescope see back. | | | |
| (5) screen 40 600 (length) (depth to top) | | | |
| 2 PVC (size) (material) | | | |
| (6) pump 1 1/2 35 (HP) (yield gpm) | | | |
| 0 (type power) | | | |
| (7) electric log no (yes or no) | | | |
| (organization running log) | | | |
| (8) how well bottom plugged Steel plug | | | |
| DRILLERS REMARKS: Water Straw Closed | | | |

CODED


Miss. Board of Water Comm.

MAY 24 1979

RECEIVED

If well telescopes please sketch and show depths.

GROUND LEVEL

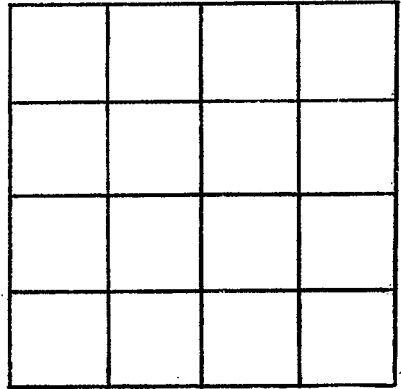

SECTION _____

Please indicate well location X.

ADDITIONAL INFORMATION

If more than one screen, show locations of each on sketch.