

42200  
U54  
4-14-79

**MISSISSIPPI**  
**BOARD OF WATER COMMISSIONERS**  
 416 North State Street  
 Jackson, Mississippi 39201

**CODED**

**WATER WELL DRILLERS LOG**

4-14 19 79 Larry's Well Pump Co Yassar  
 date well completed firm name county well located

LANDOWNER: Dickie Farms  
Sartoria miss

description of formations encountered	from	to
<u>clay</u>	<u>0</u>	<u>20</u>
<u>fine sand</u>	<u>20</u>	<u>30</u>
<u>fine to med sand</u>	<u>30</u>	<u>45</u>
<u>fine sand</u>	<u>45</u>	<u>80</u>
<u>coarse sand</u>	<u>80</u>	<u>100</u>
<u>clay</u>	<u>100</u>	<u>115</u>

(mailing address)  
 WELL LOCATION:  
 sec. 17 T. 9 N. R. 4 E. W  
S 4 W  
3 mi S miles 3 mi W of Sartoria  
 (distance) (direction) (nearest town)

WELL PURPOSE:  
 (home, irrigation, municipal, industrial)

- WELL COMPLETION DATA:
- (1) diameter (inches) 16"
  - (2) total depth (feet) 100'
  - (3) static water level (feet) 86" below top of ground.
  - (4) casing steel 80'  
(material) (depth)  
\_\_\_\_\_ if telescope see back.  
(size)
  - (5) screen 20 80'  
(length) (depth to top)  
16" steel  
(size) (material)
  - (6) pump 90 1000  
(HP) (yield gpm)  
D  
(type power)
  - (7) electric log no  
(yes or no)  
\_\_\_\_\_  
(organization running log)
  - (8) how well bottom plugged steel plate

**CODED**

Miss. Board of Water Comm.


MAY - 7 1979

DRILLERS REMARKS:

**RECEIVED**

⑥  
If well telescopes please sketch and show depths.

GROUND LEVEL

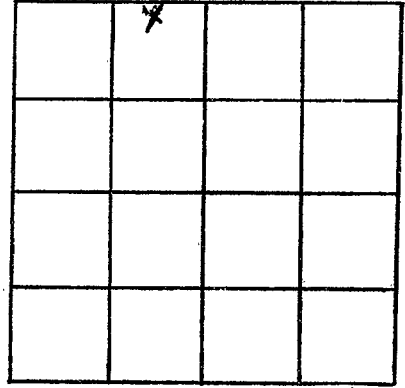

SECTION 17

Please indicate well location X:

ADDITIONAL INFORMATION

If more than one screen, show locations of each on sketch.