

4A200
U55
4-13-79

MISSISSIPPI
BOARD OF WATER COMMISSIONERS
416 North State Street
Jackson, Mississippi 39201

CODED

WATER WELL DRILLERS LOG

4-13-1979 date well completed Larry's Well Pump Co firm name Yazoo county well located

LANDOWNER: Dick's Farms

Sartoris miss

(mailing address)

WELL LOCATION:

sec. 36-T-20(N) S R-5 E W
3 mi S miles 3 W of Sartoris
(distance) (direction) (nearest town)

WELL PURPOSE:
(home, irrigation, municipal, industrial)

WELL COMPLETION DATA:

- (1) diameter (inches) 16"
- (2) total depth (feet) 115'
- (3) static water level (feet) 9 ^{below}/_{above} top of ground.
- (4) casing steel 115'
(material) (depth)
 if telescope see back.
(size)
- (5) screen 40' 75'
(length) (depth to top)
16" steel
(size) (material)
- (6) pump 90 3000
(HP) (yield gpm)

(type power)
- (7) electric log no
(yes or no)

(organization running log)
- (8) how well bottom plugged steel plate

description of formations encountered	from	to
<u>clay</u>	<u>0</u>	<u>25</u>
<u>fine sand</u>	<u>25</u>	<u>40</u>
<u>med sand</u>	<u>40</u>	<u>55</u>
<u>coarse sand</u>	<u>55</u>	<u>85</u>
<u>coarse sand & gravel</u>	<u>85</u>	<u>95</u>
<u>coarse sand</u>	<u>95</u>	<u>115</u>

CODED

DRILLERS REMARKS:


Miss. Board of Water Comm

MAY - 7 1979

RECEIVED

If well telescopes please sketch and show depths.

GROUND LEVEL

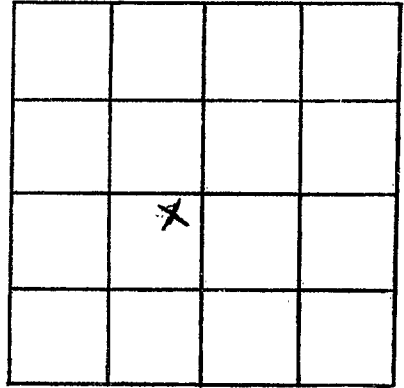

SECTION 36

Please indicate well location X:

ADDITIONAL INFORMATION

If more than one screen,
show locations of each on sketch.