

5200
 P U S
 4-12-79

MISSISSIPPI
 BOARD OF WATER COMMISSIONERS
 416 North State Street
 Jackson, Mississippi 39201

WATER WELL DRILLERS LOG **CODED**

4-12-79 19 Lamps Well & Pump Co. Y azoo
 date well completed firm name county well located

LANDOWNER: Direl Farms
Sartoria Miss.

description of formations encountered	from	to
clay	0	20
clay & fine sand	20	55
med sand	55	70
med to coarse sand	70	85
med sand	85	100
coarse sand & gravel	100	114

(mailing address)
 WELL LOCATION:
 sec. 26 T 9 N R 4 E
35 miles west of Sartoria
 (distance) (direction) (nearest town)

WELL PURPOSE:
 (home, irrigation, municipal, industrial)

CODED

- WELL COMPLETION DATA:
- (1) diameter (inches) 16"
 - (2) total depth (feet) 114'
 - (3) static water level (feet) 17' ^{below}/_{above} top of ground.
 - (4) casing steel 114'
 (material) (depth)
 (size) If telescope see back.
 - (5) screen 40 74'
 (length) (depth to top)
16" steel
 (size) (material)
 - (6) pump 90 3000
 (HP) (yield gpm)
0
 (type power)
 - (7) electric log no
 (yes or no)
 (organization running log)
 - (8) how well bottom plugged Steel plate

Miss. Board of Water Comm.


DRILLERS REMARKS:

MAY - 7 1979

RECEIVED

If well telescopes please sketch and show depths.

GROUND LEVEL

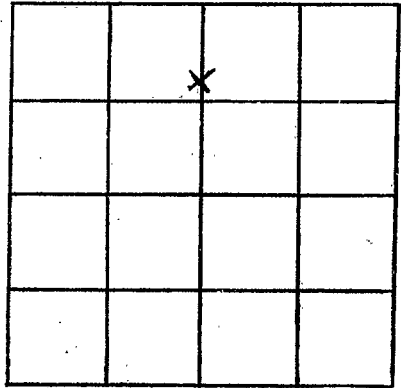

SECTION 6

Please indicate well location X.

ADDITIONAL INFORMATION

If more than one screen, show locations of each on sketch.