

MISSISSIPPI DEPARTMENT OF NATURAL RESOURCES

Bureau of Land and Water Resources

Southport Mall

P.O. Box 10631

Jackson, Mississippi 39209

WATER WELL DRILLERS LOG

CODED

24

4000  
U 57  
5/21/81

May 21 1981  
date well completed

Larry's well & Pump  
firm name

Madison  
county well located

LANDOWNER: Dixie Farms

description of formations encountered

from to

Satartia Mo.  
(mailing address)

Clay	0	40
Fine Sand	40	60
Med & Course	60	105

WELL LOCATION:

sec. 7 T. 9 N. R. 40 W.  
10 miles SW of Satartia  
(distance) (direction) (nearest town)

WELL PURPOSE:

(home, irrigation, municipal, industrial)

WELL COMPLETION DATA:

- (1) diameter (inches) 16"
- (2) total depth (feet) 105'
- (3) static water level (feet) 9' below top of ground.
- (4) casing Steel, 16.5' (material) (depth)
- (size) if telescope see back.
- (5) screen 40' 65' (length) (depth to top)
- 16" Steel (size) (material)
- (6) pump 60 3000 (HP) (yield gpm)

CODED

- (7) electric log (yes or no) Yes 1:6V  
(organization running log)

- (8) how well bottom plugged  
Steel Plate


DRILLERS REMARKS:

DEPT. OF NATURAL RESOURCES  
BUREAU OF LAND & WATER RESOURCES  
OCT 19 1981  
RECEIVED

8

If well telescopes please sketch and show depths.

GROUND LEVEL

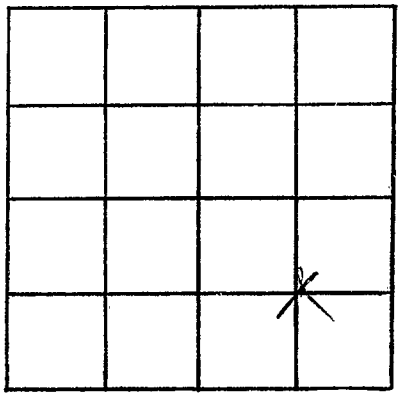

SECTION 7

Please indicate well location X.

ADDITIONAL INFORMATION

A series of horizontal lines for recording additional information.

If more than one screen, show locations of each on sketch.