

MISSISSIPPI DEPARTMENT OF NATURAL RESOURCES

Bureau of Land and Water Resources

Southport Mall

P.O. Box 10631

Jackson, Mississippi 39209

WATER WELL DRILLERS LOG

CODED

4200  
21058  
5/22/81

May 22 1981 Larry's well & pump 4200  
date well completed firm name county well located

LANDOWNER: <u>Dixie Farms</u>	description of formations encountered	from	to
<u>Satantia, Ms.</u> (mailing address)	<u>Clay</u> <u>Fine Sand</u> <u>Med &amp; Course Sand</u>	<u>0</u> <u>35</u> <u>55</u>	<u>35</u> <u>55</u> <u>105</u>
<p>WELL LOCATION:</p> <p>sec. <u>7</u> T <u>9</u> N R. <u>4</u> E  <u>10</u> miles <u>SW</u> of <u>Satantia</u>                      (distance) (direction) (nearest town)</p>			
<p>WELL PURPOSE: (home, irrigation, municipal, industrial)</p>			
<p>WELL COMPLETION DATA:</p>			
<p>(1) diameter (inches) <u>16"</u></p>			
<p>(2) total depth (feet) <u>105'</u></p>			
<p>(3) static water level (feet) <u>12</u> below above top of ground.</p>			
<p>(4) casing <u>Steel</u>, <u>85'</u> (material) (depth)</p> <p>(size) if telescope see back.</p>			
<p>(5) screen <u>20'</u>, <u>85'</u> (length) (depth to top)</p>			
<p><u>16"</u>, <u>Steel</u> (size) (material)</p>			
<p>(6) pump <u>200</u>, <u>3000</u> (HP) (yield gpm)</p>			
<p>(type power)</p>			
<p>(7) electric log <u>No</u> (yes or no)</p>			
<p>(organization running log)</p>			
<p>(8) how well bottom plugged <u>Steel Plate</u></p>			
<p>DRILLERS REMARKS:</p>			

CODED

DEPT OF NATURAL RESOURCES  
BUREAU OF LAND AND WATER RESOURCES


OCT 19 1981

RECEIVED

2

If well telescopes please sketch and show depths.

GROUND LEVEL

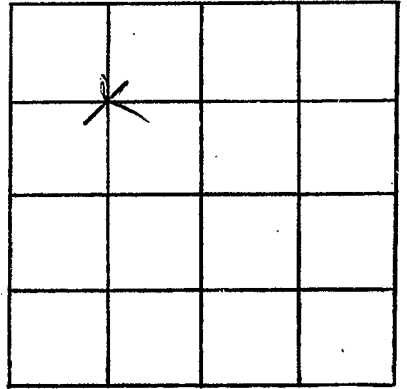

SECTION 7

Please indicate well location X.

ADDITIONAL INFORMATION

If more than one screen,  
show locations of each on sketch.