

MISSISSIPPI DEPARTMENT OF NATURAL RESOURCES

Bureau of Land and Water Resources

Southport Mall

P.O. Box 10631

Jackson, Mississippi 39209

WATER WELL DRILLERS LOG

CODED

Yazoo
91 59
5-22-81

May 22 1981 Larry's well & pump Yazoo
date well completed firm name county well located

LANDOWNER: Dixie Farms
Satartia, Ms.
(mailing address)

description of formations encountered	from	to
<u>Clay</u>	<u>0</u>	<u>37</u>
<u>Fine Sand</u>	<u>37</u>	<u>56</u>
<u>Med. to Coarse Sand</u>	<u>56</u>	<u>104</u>

WELL LOCATION:
sec. 7 T. 9 N. R. 4 E
10 miles SW of Satartia
(distance) (direction) (nearest town)

WELL PURPOSE:
(home, irrigation, municipal, industrial)

WELL COMPLETION DATA:

(1) diameter (inches) 16"

(2) total depth (feet) 104

(3) static water level (feet) 12 below above top of ground.

(4) casing Steel, 84'
(material) (depth)
16" if telescope see back.
(size)

(5) screen 20', 84'
(length) (depth to top)
16", Steel
(size) (material)

(6) pump 100 3000
(HP) (yield gpm)
(type power)

(7) electric log no
(yes or no)
(organization running log)

(8) how well bottom plugged Steel
plate

CODED

DEPT. OF NATURAL RESOURCES
BUREAU OF LAND & WATER RESOURCES

OCT 19 1981


RECEIVED

DRILLERS REMARKS:

7

If well telescopes please sketch and show depths.

GROUND LEVEL

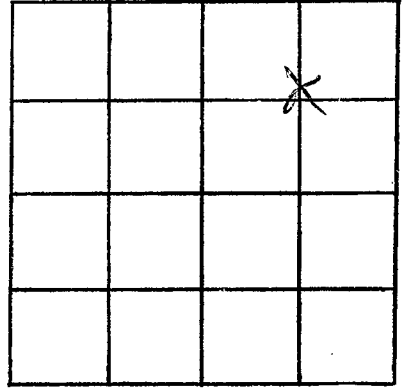

SECTION 7

Please indicate well location X.

ADDITIONAL INFORMATION

If more than one screen, show locations of each on sketch.