

MISSISSIPPI DEPARTMENT OF NATURAL RESOURCES

Bureau of Land and Water Resources

Southport Mall

P.O. Box 10631

Jackson, Mississippi 39209

WATER WELL DRILLERS LOG

CODED

Yazoo
U 60
5-22-81

May 22 1981
date well completed

Larange well & pump
firm name

Yazoo
county well located

LANDOWNER:	description of formations encountered	from	to
DIXIE Farms			
Satartia, Mo. (mailing address)	Clay	0	40
	Fine Sand	40	60
	Med to Coarse Sand	60	105
WELL LOCATION:			
sec. <u>7</u> T <u>9</u> N R <u>4</u> E			
<u>10</u> miles <u>SW</u> of <u>Satartia</u> (distance) (direction) (nearest town)			
WELL PURPOSE: (home, irrigation, municipal, industrial)			
WELL COMPLETION DATA:			
(1) diameter (inches)	<u>16"</u>		
(2) total depth (feet)	<u>105'</u>		
(3) static water level (feet)	<u>10</u> below top of ground.		
(4) casing (material)	<u>Steel</u>		
(size)	<u>65</u> (depth)		
(5) screen (length)	<u>40'</u>		
(size)	<u>16"</u>		
(6) pump (HP)	<u>3000</u> (yield gpm)		
(7) electric log (yes or no)	<u>No</u>		
(8) how well bottom plugged	<u>Steel Plate</u>		
DRILLERS REMARKS:			

CODED


DEPT. OF NATURAL RESOURCES
BUREAU OF LAND & WATER RESOURCES

MAY 19 1981

RECEIVED

8
If well telescopes please sketch and show depths.

GROUND LEVEL

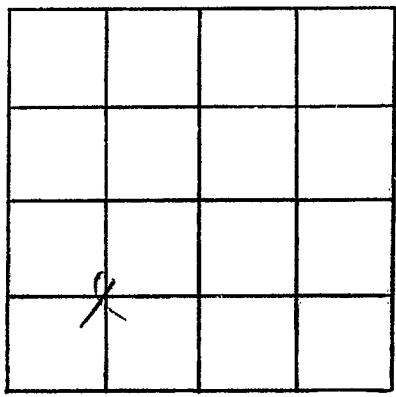

SECTION 7

Please indicate well location X.

ADDITIONAL INFORMATION

If more than one screen, show locations of each on sketch.