

MISSISSIPPI DEPARTMENT OF NATURAL RESOURCES

Bureau of Land and Water Resources

Southport Mall

P.O. Box 10631

Jackson, Mississippi 39209

WATER WELL DRILLERS LOG

CODED

Yonzo
U.C.I.
5-23-81

May 23 1981 Larry's well & pump Yonzo
date well completed firm name county well located

LANDOWNER: <u>DIXIE FARMS</u>	description of formations encountered	from	to
<u>Satsuma Mo.</u> (mailing address)	<u>Clay</u> <u>fine sand</u> <u>Med to coarse sand</u>	<u>0</u> <u>36</u> <u>50</u>	<u>36</u> <u>50</u> <u>104</u>
<p>WELL LOCATION: sec. <u>13</u> T. <u>9</u> N. R. <u>5</u> <u>11</u> miles <u>SW</u> of <u>Satsuma</u> (distance) (direction) (nearest town)</p>			
<p>WELL PURPOSE: (home, irrigation, municipal, industrial)</p>			
<p>WELL COMPLETION DATA:</p>			
<p>(1) diameter (inches) <u>16"</u></p>			
<p>(2) total depth (feet) <u>104</u></p>			
<p>(3) static water level (feet) <u>11</u> <u>below</u> above top of ground.</p>			
<p>(4) casing <u>Steel</u>, <u>84</u> (material) (depth)</p>			
<p>(size) if telescope see back.</p>			
<p>(5) screen <u>20'</u>, <u>84'</u> (length) (depth to top)</p>			
<p><u>16"</u>, <u>Steel</u> (size) (material)</p>			
<p>(6) pump <u>60</u>, <u>300</u> (HP) (yield gpm)</p>			
<p>(type power)</p>			
<p>(7) electric log <u>No</u> (yes or no)</p>			
<p>(organization running log)</p>			
<p>(8) how well bottom plugged <u>Steel Plate</u></p>			
<p>DRILLERS REMARKS:</p>			

CODED


DEPT. OF NATURAL RESOURCES
BUREAU OF LAND & WATER RESOURCES

OCT 19 1981

RECEIVED

If well telescopes please sketch and show depths.

GROUND LEVEL

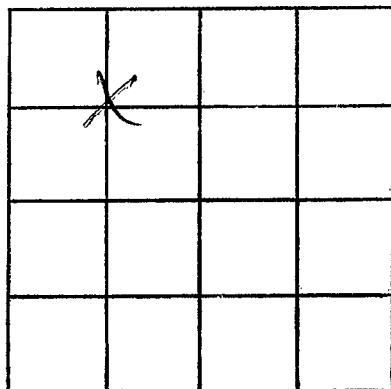

SECTION 13

Please indicate well location X.

ADDITIONAL INFORMATION

If more than one screen, show locations of each on sketch.