

MISSISSIPPI DEPARTMENT OF NATURAL RESOURCES

Bureau of Land and Water Resources

Southport Mall

P.O. Box 10631

Jackson, Mississippi 39209

WATER WELL DRILLERS LOG

CODED

2000
U 22
5-23-81

May 23 1981 date well completed
 Larry's well & pump firm name
 Yazoo county well located

LANDOWNER: <u>DINIE Farms</u>	description of formations encountered	from	to
<u>Satanta, Mo</u> (mailing address)	<u>Clay</u> <u>fine Sand</u> <u>Med to coarse Sand</u>	<u>0</u> <u>37</u> <u>100</u>	<u>37</u> <u>60</u> <u>105</u>
<p>WELL LOCATION:</p> <p>sec. <u>13</u> T <u>9</u> N R <u>5</u> E</p> <p><u>11</u> miles <u>SW</u> of <u>Satanta</u></p> <p>(distance) (direction) (nearest town)</p>			
<p>WELL PURPOSE:</p> <p>(home, irrigation, municipal, industrial)</p>			
<p>WELL COMPLETION DATA:</p> <p>(1) diameter (inches) <u>16"</u></p> <p>(2) total depth (feet) <u>105</u></p> <p>(3) static water level (feet) <u>10</u> below top of ground.</p> <p>(4) casing <u>Steel</u>, <u>85'</u> (material), (depth)</p> <p>(size) if telescope see back.</p> <p>(5) screen <u>20'</u>, <u>85'</u> (length), (depth to top)</p> <p><u>16"</u>, <u>Steel</u> (size), (material)</p> <p>(6) pump <u>60</u>, <u>3000</u> (HP), (yield gpm)</p> <p>(type power)</p> <p>(7) electric log <u>No</u> (yes or no)</p> <p>(organization running log)</p> <p>(8) how well bottom plugged <u>Steel</u> <u>Plate</u></p>			
<p>DRILLERS REMARKS:</p>			

CODED

DEPT. OF NATURAL RESOURCES
 BUREAU OF LAND & WATER RESOURCES


OCT 19 1981

RECEIVED

2

If well telescopes please sketch and show depths.

GROUND LEVEL

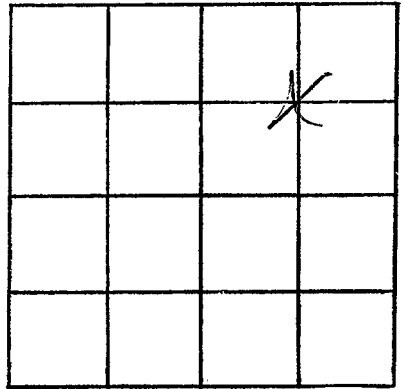

SECTION 13

Please indicate well location X.

ADDITIONAL INFORMATION

If more than one screen, show locations of each on sketch.