

MISSISSIPPI DEPARTMENT OF NATURAL RESOURCES

Bureau of Land and Water Resources

Southport Mall

P.O. Box 10631

Jackson, Mississippi 39209

WATER WELL DRILLERS LOG

CODED

Yazoo
U 63
5-23-81

date well completed May 23 1981 firm name Larry's well & pump county well located Yazoo

LANDOWNER: <u>Dixie Farms</u>	description of formations encountered	from	to
<u>Satartia Ms.</u> (mailing address)	<u>Clay</u>	<u>0</u>	<u>35</u>
WELL LOCATION: sec. <u>13</u> T <u>9</u> N R <u>5</u> <u>11</u> miles <u>SW</u> of <u>Satartia</u> (distance) (direction) (nearest town)	<u>Fine Sand</u>	<u>35</u>	<u>60</u>
WELL PURPOSE: (home, irrigation, municipal, industrial)	<u>Med. to Coarse Sand</u>	<u>60</u>	<u>105</u>
WELL COMPLETION DATA: (1) diameter (inches) <u>16"</u> (2) total depth (feet) <u>105</u> (3) static water level (feet) <u>11</u> below above top of ground. (4) casing <u>Steel</u> , <u>85'</u> (material) (depth) <u>16</u> if telescope see back. (size) (5) screen <u>20'</u> , <u>85'</u> (length) (depth to top) <u>16"</u> , <u>Steel</u> (size) (material) (6) pump <u>100</u> <u>3000</u> (HP) (yield gpm) (type power) (7) electric log <u>No</u> (yes or no) (organization running log) (8) how well bottom plugged <u>Steel Plate</u>			
DRILLERS REMARKS:			

CODED

DEPT. OF NATURAL RESOURCES
BUREAU OF LAND & WATER RESOURCES


OCT 19 1981

RECEIVED

0

If well telescopes please sketch and show depths.

GROUND LEVEL

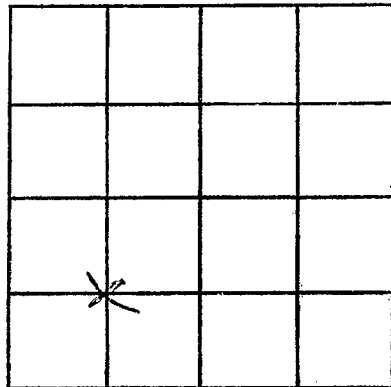

SECTION 13

Please indicate well location X.

ADDITIONAL INFORMATION

If more than one screen,
show locations of each on sketch.