

MISSISSIPPI DEPARTMENT OF NATURAL RESOURCES

Bureau of Land and Water Resources

Southport Mall

P.O. Box 10631

Jackson, Mississippi 39209 CODED

WATER WELL DRILLERS LOG

4000
1164
5-24-81

May 24 1981
date well completed

Larry's well & pump
firm name

4000
county well located

LANDOWNER: Dixie Farms

description of formations encountered

from

to

Dartaria Ms.

(mailing address)

Clay	0	41
Fine Sand	41	60
Mel to Coarse Sand	60	105

WELL LOCATION:

sec. 13 T 9 N R 5 E
11 miles SW of Dartaria
(distance) (direction) (nearest town)

WELL PURPOSE:

(home, irrigation, municipal, industrial)

WELL COMPLETION DATA:

(1) diameter (inches) 16"
(2) total depth (feet) 105'
(3) static water level (feet) 11 below top of ground.

(4) casing Steel, 65'
(material) (depth)

(size) if telescope see back.

(5) screen 40', 65'
(length) (depth to top)

16" Steel
(size) (material)

(6) pump 60 3000
(HP) (yield gpm)

(type power)

(7) electric log no
(yes or no)

(organization running log)

(8) how well bottom plugged Steel Plate

DRILLERS REMARKS:

CODED

DEPT. OF NATURAL RESOURCES
BUREAU OF LAND & WATER RESOURCES


UGT 10 1981

RECEIVED



If well telescopes please sketch and show depths.

GROUND LEVEL

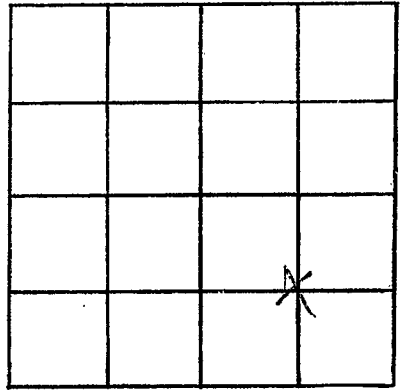

SECTION 113

Please indicate well location X.

ADDITIONAL INFORMATION

If more than one screen, show locations of each on sketch.