

MISSISSIPPI DEPARTMENT OF NATURAL RESOURCES

Bureau of Land and Water Resources

Southport Mall

P.O. Box 10631

Jackson, Mississippi 39209

WATER WELL DRILLERS LOG

CODED

Year
1981
5-24-81

May 24 1981 Laurie's Well & Pump Wayne
 date well completed firm name county well located

LANDOWNER: Dixie Farms description of formations encountered from to

<u>Intantia, ms.</u> (mailing address)	<u>Clay</u>	<u>0</u>	<u>30</u>
	<u>Fine Sand</u>	<u>30</u>	<u>57</u>
	<u>Med to Coarse Sand</u>	<u>57</u>	<u>105</u>

WELL LOCATION:
 sec. 18 T. 9 N. R. 4
11 miles SW of Intantia
 (distance) (direction) (nearest town)

WELL PURPOSE:
 (home, irrigation, municipal, industrial)

WELL COMPLETION DATA:

(1) diameter (inches) 16"

(2) total depth (feet) 105'

(3) static water level (feet) 10 below above top of ground.

(4) casing steel, 65'
 (material) (depth)
 (size) if telescope see back.

(5) screen 40', 65'
 (length) (depth to top)
16", steel
 (size) (material)

(6) pump 100 3000
 (HP) (yield gpm)
 (type power)

(7) electric log No
 (yes or no)
 (organization running log)

(8) how well bottom plugged Steel Plate

CODED

DEPT. OF NATURAL RESOURCES
 BUREAU OF LAND & WATER RESOURCES


UGL 19 1981

RECEIVED

DRILLERS REMARKS:

If well telescopes please sketch and show depths.

GROUND LEVEL

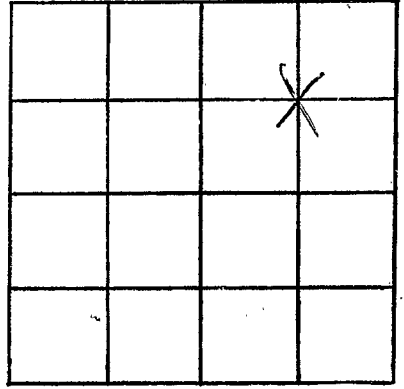

SECTION

18

Please indicate well location X.

ADDITIONAL INFORMATION

A series of horizontal lines provided for entering additional information.

If more than one screen, show locations of each on sketch.