

MISSISSIPPI DEPARTMENT OF NATURAL RESOURCES

Bureau of Land and Water Resources

Southport Mall

P.O. Box 10631

Jackson, Mississippi 39209 **CODED**

WATER WELL DRILLERS LOG

Yazoo
4066
5-25-81

date well completed May 25 19 81 firm name Larry's well & pump county well located Yazoo

LANDOWNER: DIXIE Farms
Satartia, ms.
 (mailing address)

description of formations encountered	from	to
<u>Clay</u>	<u>0</u>	<u>30</u>
<u>fine sand</u>	<u>30</u>	<u>57</u>
<u>Course Sand</u>	<u>57</u>	<u>104</u>

WELL LOCATION:
 sec. 18 T 9 N R 4 E
11 miles SW of Satartia
 (distance) (direction) (nearest town)

WELL PURPOSE:
 (home, irrigation, municipal, industrial)

WELL COMPLETION DATA:

(1) diameter (inches) 16"

(2) total depth (feet) 105

(3) static water level (feet) 11 below above top of ground.

(4) casing steel 65'
 (material) (depth)
 (size) if telescope see back.

(5) screen 40' 65'
 (length) (depth to top)
16" steel
 (size) (material)

(6) pump 100 7000
 (HP) (yield gpm)
 (type power)

(7) electric log NO
 (yes or no)
 (organization running log)

(8) how well bottom plugged steel
Plate

DRILLERS REMARKS:

CODED

DEPT. OF NATURAL RESOURCES
 BUREAU OF LAND & WATER RESOURCES


MAY 19 1981

RECEIVED

9

If well telescopes please sketch and show depths.

GROUND LEVEL

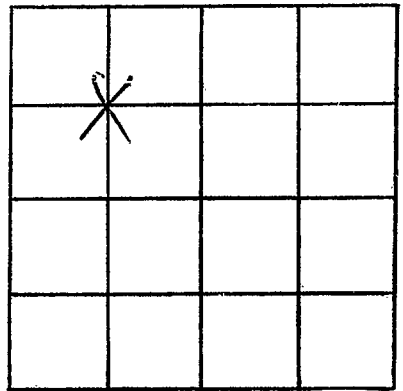

SECTION

18

Please indicate well location X.

ADDITIONAL INFORMATION

If more than one screen, show locations of each on sketch.