

MISSISSIPPI DEPARTMENT OF NATURAL RESOURCES

Bureau of Land and Water Resources

Southport Mall

P.O. Box 10631

Jackson, Mississippi 39209

WATER WELL DRILLERS LOG

CODED

YA 200
U 67
5/25/81

May 25 1981
date well completed

Larry's Well & Pump
firm name

Yazoo
county well located

LANDOWNER: Dixie Farms
Dataria, Mo
(mailing address)

description of formations encountered

from to

Clay	0	37
Fine to Med	37	61
Med to Course Sand	61	105

WELL LOCATION:
sec. 18 T 9 N R 4 E
11 miles SWS of Dataria
(distance) (direction) (nearest town)

WELL PURPOSE:
(home, irrigation, municipal, industrial)

CODED

WELL COMPLETION DATA:

(1) diameter (inches) 16"

(2) total depth (feet) 105'

(3) static water level (feet) 12 below top of ground.

(4) casing steel, 65' (material), (depth), (size) if telescope see back.

(5) screen 40' (length), 65' (depth to top), 16" (size), steel (material)

(6) pump 60 (HP), 3000 (yield gpm), (type power)

(7) electric log NO (yes or no), (organization running log)

(8) how well bottom plugged steel Plate

DEPT. OF NATURAL RESOURCES
BUREAU OF LAND & WATER RESOURCES

OCT 19 1981


RECEIVED

DRILLERS REMARKS:

8

If well telescopes please sketch and show depths.

GROUND LEVEL

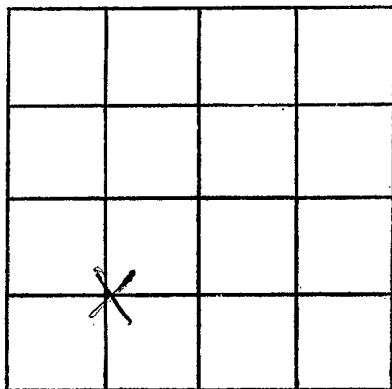

SECTION 18

Please indicate well location X.

ADDITIONAL INFORMATION

If more than one screen, show locations of each on sketch.