

MISSISSIPPI DEPARTMENT OF NATURAL RESOURCES

Bureau of Land and Water Resources

Southport Mall

P.O. Box 10631

Jackson, Mississippi 39209

WATER WELL DRILLERS LOG

CODED

Yazoo
U 68
5/25/81

date well completed May 25 1981

firm name Larry's Wells Pump

county well located Yazoo

LANDOWNER: Dixie Farms

description of formations encountered

from

to

Satartia, Ms.

(mailing address)

<u>Clay</u>	<u>0</u>	<u>40</u>
<u>Fine Sand</u>	<u>40</u>	<u>63</u>
<u>Mel to Course</u>	<u>63</u>	<u>105</u>

WELL LOCATION:

sec. 18 T 9 N R. 4 E

11 miles SW of Satartia
(distance) (direction) (nearest town)

WELL PURPOSE:

(home, irrigation, municipal, industrial)

CODED

WELL COMPLETION DATA:

- (1) diameter (inches) 16"
 (2) total depth (feet) 105'
 (3) static water level (feet) 10 below above top of ground.

- (4) casing steel, 65'
(material) (depth)

(size) if telescope see back.

- (5) screen 40', 65'
(length) (depth to top)

16", steel
(size) (material)

- (6) pump 100, 3000
(HP) (yield gpm)

(type power)

- (7) electric log no
(yes or no)

(organization running log)

- (8) how well bottom plugged Steel Plate

DRILLERS REMARKS:

DEPT. OF NATURAL RESOURCES
BUREAU OF LAND & WATER RESOURCES


OCT 15 1981

RECEIVED

18

If well telescopes please sketch and show depths.

GROUND LEVEL

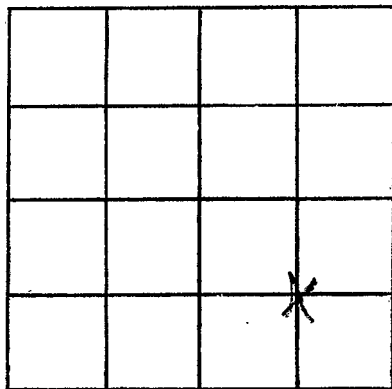

SECTION 18

Please indicate well location X.

ADDITIONAL INFORMATION

If more than one screen, show locations of each on sketch.