

MISSISSIPPI DEPARTMENT OF NATURAL RESOURCES

Bureau of Land and Water Resources

Southport Mall

P.O. Box 10631

Jackson, Mississippi 39209

WATER WELL DRILLERS LOG

CODED

Yonzo  
U 69  
6-25-81

June 25 19 81 date well completed  
Larry's well & pump firm name  
Yonzo county well located

LANDOWNER:	description of formations encountered	from	to
Dottie Farms	CLAY	0	65
Dotatie, Mo. (mailing address)	FINE SAND	65	70
	COURSE SAND	70	98
WELL LOCATION:			
sec. 12 T. 9 N R. 5 E			
10 miles SW of Dotatie (distance) (direction) (nearest town)			
WELL PURPOSE: (home, irrigation, municipal, industrial)			
WELL COMPLETION DATA:			
(1) diameter (inches) 16"			
(2) total depth (feet) 98'			
(3) static water level (feet) 12 below above top of ground.			
(4) casing steel, 78' (material) (depth)			
(size) If telescope see back.			
(5) screen 20', 78' (length) (depth to top)			
16", steel (size) (material)			
(6) pump 60, 3000 (HP) (yield gpm)			
(type power)			
(7) electric log no. (yes or no)			
(organization running log)			
(8) how well bottom plugged Steel Plate			
DRILLERS REMARKS:			

CODED


DEPT. OF NATURAL RESOURCES  
BUREAU OF LAND & WATER RESOURCES

OCT 19 1981

RECEIVED

If well telescopes please sketch and show depths.

GROUND LEVEL

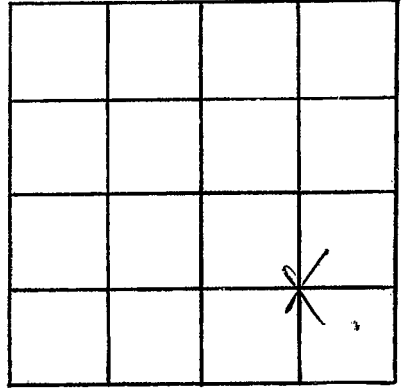

SECTION 12

Please indicate well location X.

ADDITIONAL INFORMATION

A series of horizontal lines for entering additional information.

If more than one screen, show locations of each on sketch.