

MISSISSIPPI DEPARTMENT OF NATURAL RESOURCES

Bureau of Land and Water Resources

Southport Mall

P.O. Box 10631

Jackson, Mississippi 39209

WATER WELL DRILLERS LOG

CODED

Yazoo  
W 070  
6-25-81

June 25, 1981 date well completed  
Larry's Well & Pump firm name  
Yazoo county well located

| LANDOWNER: <u>Dixie Farms</u>  | description of formations encountered  | from                   | to                     |
|--|--|------------------------|------------------------|
| <u>Pataula, Mo</u><br>(mailing address)  | <u>CLAY</u><br><u>MED. COARSE SAND</u> | <u>0</u><br><u>170</u> | <u>48</u><br><u>48</u> |
| <b>WELL LOCATION:</b><br>sec. <u>12</u> - T <u>9</u> N R. <u>5</u> E<br><u>10</u> miles <u>SW</u> of <u>Pataula</u><br>(distance) (direction) (nearest town) |  |                        |                        |
| <b>WELL PURPOSE:</b><br>(home, irrigation, municipal, industrial)  |  |                        |                        |
| <b>WELL COMPLETION DATA:</b> <span style="float: right;">CODED</span>  |  |                        |                        |
| (1) diameter (inches) <u>16"</u>   |  |                        |                        |
| (2) total depth (feet) <u>98'</u>  |  |                        |                        |
| (3) static water level (feet) <u>13</u> below above top of ground.   |  |                        |                        |
| (4) casing <u>steel</u> , <u>78'</u><br>(material) (depth)<br><u>        </u> if telescope see back.<br>(size)   |  |                        |                        |
| (5) screen <u>20'</u> , <u>78'</u><br>(length) (depth to top)  |  |                        |                        |
| (6) pump <u>16"</u> , <u>steel</u><br>(size) (material)  |  |                        |                        |
| (7) pump <u>600</u> , <u>3000</u><br>(HP) (yield gpm)  |  |                        |                        |
| (type power)   |  |                        |                        |
| (8) electric log <u>NO</u><br>(yes or no)  |  |                        |                        |
| (organization running log)   |  |                        |                        |
| (8) how well bottom plugged <u>Steel Plate</u>   |  |                        |                        |
| DRILLERS REMARKS:  |  |                        |                        |


DEPT. OF NATURAL RESOURCES  
BUREAU OF LAND & WATER RESOURCES

OCT 19 1981

RECEIVED

If well telescopes please sketch and show depths.

GROUND LEVEL

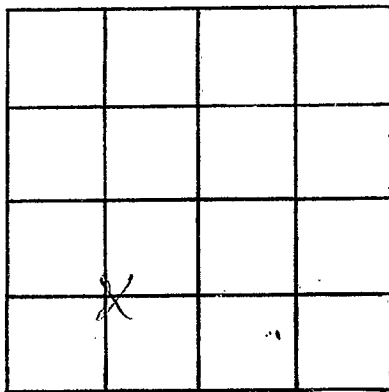

SECTION 12

Please indicate well location X.

ADDITIONAL INFORMATION

If more than one screen, show locations of each on sketch.