

MISSISSIPPI DEPARTMENT OF NATURAL RESOURCES

Bureau of Land and Water Resources

Southport Mall

P.O. Box 10631

CODED

Jackson, Mississippi 39209

WATER WELL DRILLERS LOG

Yazoo  
71  
6-26-81

June 26 1981 date well completed Larry's Well & Pump firm name Yazoo county well located

LANDOWNER: Dicie James  
Satsuma, Mo  
(mailing address)

description of formations encountered	from	to
CLAY	0	70
CORSE SAND	70	99

WELL LOCATION:  
sec. 12 T 9 N R. 50  
10 miles SW of Satsuma  
(distance) (direction) (nearest town)

WELL PURPOSE:  
(home, irrigation, municipal, industrial)

CODED

- WELL COMPLETION DATA:
- (1) diameter (inches) 16"
  - (2) total depth (feet) 98'
  - (3) static water level (feet) 11 below above top of ground.
  - (4) casing Steel, 78'  
(material) (depth)  
\_\_\_\_\_ if telescope see back.  
(size)
  - (5) screen 20', 78'  
(length) (depth to top)  
16", Steel  
(size) (material)
  - (6) pump 60 3000  
(HP) (yield gpm)  
(type power)
  - (7) electric log No  
(yes or no)  
(organization running log)
  - (8) how well bottom plugged Steel Plate

DRILLERS REMARKS:

DEPT. OF NATURAL RESOURCES  
BUREAU OF LAND & WATER RESOURCES


OCT 19 1981

RECEIVED

2

If well telescopes please sketch and show depths.

GROUND LEVEL

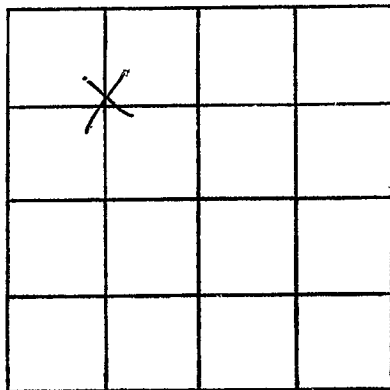

SECTION 12

Please indicate well location X.

ADDITIONAL INFORMATION

Lined area for additional information.

If more than one screen, show locations of each on sketch.