

MISSISSIPPI DEPARTMENT OF NATURAL RESOURCES

Bureau of Land and Water Resources

Southport Mall

P.O. Box 10631

Jackson, Mississippi 39209

WATER WELL DRILLERS LOG

CODED

Yazoo  
U 72  
6-26-81

date well completed June 26 1981 firm name Larry's Well & Pump county well located Yazoo

LANDOWNER: <u>Dixie Farms</u>	description of formations encountered	from	to
<u>Satonia, Ms.</u> (mailing address)	<u>CLAY</u>	<u>0</u>	<u>70</u>
WELL LOCATION: sec. <u>12</u> T. <u>9</u> N R. <u>5</u> <u>10</u> miles <u>SW</u> of <u>Satonia</u> (distance) (direction) (nearest town)	<u>COARSE SAND</u>	<u>70</u>	<u>98</u>
WELL PURPOSE: (home, irrigation, municipal, industrial)			
WELL COMPLETION DATA:			
(1) diameter (inches) <u>16"</u>			
(2) total depth (feet) <u>98'</u>			
(3) static water level (feet) <u>10</u> below <del>above</del> top of ground.			
(4) casing <u>Steel</u> , <u>78'</u> (material) (depth)			
_____ If telescope see back. (size)			
(5) screen <u>20'</u> , <u>78'</u> (length) (depth to top)			
<u>16"</u> , <u>Steel</u> (size) (material)			
(6) pump <u>60</u> , <u>3000</u> (HP) (yield gpm)			
_____ (type power)			
(7) electric log <u>No.</u> (yes or no)			
_____ (organization running log)			
(8) how well bottom plugged <u>Steel Plate</u>			
DRILLERS REMARKS:			

CODED


MISSISSIPPI DEPARTMENT OF NATURAL RESOURCES  
BUREAU OF LAND & WATER RESOURCES

OCT 10 1981

RECEIVED

If well telescopes please sketch and show depths.

GROUND LEVEL

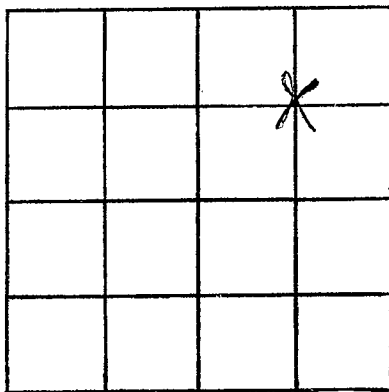

SECTION 12

Please indicate well location X.

ADDITIONAL INFORMATION

If more than one screen,  
show locations of each on sketch.