

MISSISSIPPI DEPARTMENT OF NATURAL RESOURCES

Bureau of Land and Water Resources

Southport Mall

P.O. Box 10631


Jackson, Mississippi 39209

WATER WELL DRILLERS LOG

CODED


Wazoo
WU 73
6-30-81

date well completed June 30 1981 firm name Larrop's well & pump county well located Wazoo

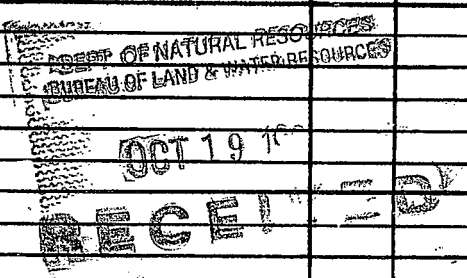LANDOWNER: <u>Dixie Farms</u>	description of formations encountered	from	to
<u>Satsuma, Mo.</u> (mailing address)	<u>CLAY</u>	<u>0</u>	<u>55</u>
WELL LOCATION: sec. <u>11</u> -T- <u>9</u> -N R. <u>5</u> <u>10</u> miles <u>SW</u> of <u>Satsuma</u> (distance) (direction) (nearest town)	<u>FINE SAND</u>	<u>55</u>	<u>65</u>
WELL PURPOSE: (home, irrigation, municipal, industrial)	<u>COARSE SAND</u>	<u>65</u>	<u>91</u>
WELL COMPLETION DATA:	CODED		
(1) diameter (inches) <u>16"</u>			
(2) total depth (feet) <u>91'</u>			
(3) static water level (feet) <u>13</u> below above top of ground.			
(4) casing <u>Steel</u> , <u>71'</u> (material) (depth) <u> </u> if telescope see back. (size)			
(5) screen <u>20'</u> , <u>71'</u> (length) (depth to top)			
<u>16</u> , <u>Steel</u> (size) (material)			
(6) pump <u>60</u> , <u>300</u> (HP) (yield gpm)			
<u> </u> (type power)			
(7) electric log <u>No</u> (yes or no)			
<u> </u> (organization running log)			
(8) how well bottom plugged <u>Steel Plate</u>			
DRILLERS REMARKS:	<div style="text-align: center;">  </div>		

If well telescopes please sketch and show depths.

GROUND LEVEL

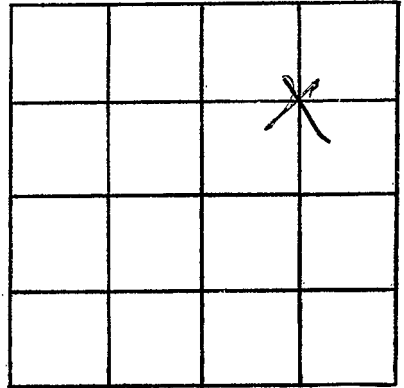

SECTION 11

Please indicate well location X.

ADDITIONAL INFORMATION

If more than one screen,
show locations of each on sketch.