

MISSISSIPPI DEPARTMENT OF NATURAL RESOURCES

Bureau of Land and Water Resources

Southport Mall

P.O. Box 10631

Jackson, Mississippi 39209

WATER WELL DRILLERS LOG

CODED

Yazoo  
01074  
6-30-81

date well completed June 30 1981 firm name Larvig Well & Pump county well located Yazoo

LANDOWNER: <u>Dodie Farms</u>	description of formations encountered	from	to
<u>Satartia, Ms</u> (mailing address)	<u>CLAY</u> <u>CORSE SAND</u>	<u>0</u> <u>70</u>	<u>70</u> <u>99</u>
WELL LOCATION: sec. <u>11</u> T. <u>9</u> N R. <u>5</u> E <u>10</u> miles <u>SW</u> of <u>Satartia</u> (distance) (direction) (nearest town)			
WELL PURPOSE: (home, irrigation, municipal, industrial)			
WELL COMPLETION DATA:			CODED
(1) diameter (inches) <u>16"</u>			
(2) total depth (feet) <u>98'</u>			
(3) static water level (feet) <u>11</u> below above top of ground.			
(4) casing <u>Steel</u> , <u>78'</u> (material) (depth)			
_____ if telescope see back. (size)			
(5) screen <u>20'</u> , <u>78'</u> (length) (depth to top)			
(6) pump <u>16"</u> , <u>Steel</u> (size) (material)			
(7) pump <u>60</u> , <u>3000</u> (HP) (yield gpm)			
_____ (type power)			
(8) electric log <u>No.</u> (yes or no)			
_____ (organization running log)			
(8) how well bottom plugged <u>Steel</u> <u>Plate</u>			
DRILLERS REMARKS:			


MISSISSIPPI DEPARTMENT OF NATURAL RESOURCES  
BUREAU OF LAND AND WATER RESOURCES

JUN 19 1981

RECEIVED

If well telescopes please sketch and show depths.

GROUND LEVEL

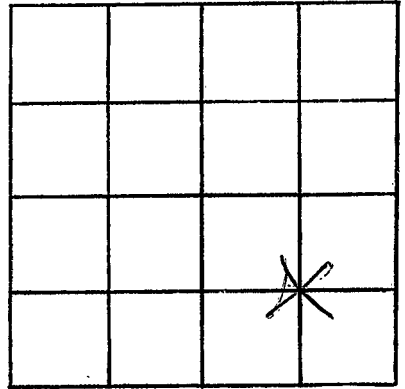

SECTION 11

Please indicate well location X.

ADDITIONAL INFORMATION

If more than one screen, show locations of each on sketch.