

MISSISSIPPI DEPARTMENT OF NATURAL RESOURCES

Bureau of Land and Water Resources

Southport Mall

P.O. Box 10631

Jackson, Mississippi 39209

WATER WELL DRILLERS LOG

CODED

Yazoo  
U 76  
7-13-81

July 13 1981 Larry's well & Pump Yazoo  
date well completed firm name county well located

LANDOWNER: <u>Dixie Farms</u>	description of formations encountered	from	to
<u>Dattania, Mo.</u> (mailing address)		<u>CLAY</u> <u>FINE SAND</u> <u>COURSE SAND</u>	<u>0</u> <u>35</u> <u>65</u>
<b>WELL LOCATION:</b>			
sec. <u>12</u> T <u>9</u> N R. <u>5</u> E			
<u>10</u> miles <u>SW</u> of <u>Dattania</u> (distance) (direction) (nearest town)			
<b>WELL PURPOSE:</b> (home, irrigation, municipal, industrial)			
<b>WELL COMPLETION DATA:</b>			
(1) diameter (inches) <u>16"</u>			
(2) total depth (feet) <u>98'</u>			
(3) static water level (feet) <u>13</u> below above top of ground.			
(4) casing <u>Steel</u> , <u>78'</u> , (material) (depth)			
(size) If telescope see back.			
(5) screen <u>20'</u> , <u>78'</u> (length) (depth to top)			
<u>16"</u> , <u>Steel</u> (size) (material)			
(6) pump <u>60</u> <u>3000</u> (HP) (yield gpm)			
(type power)			
(7) electric log <u>No</u> (yes or no)			
(organization running log)			
(8) how well bottom plugged <u>Steel Plate</u>			

CODED


RECEIVED  
MISSISSIPPI DEPARTMENT OF NATURAL RESOURCES  
BUREAU OF LAND & WATER RESOURCES  
OCT 10 1981  
RECEIVED

DRILLERS REMARKS:

②

If well telescopes please sketch and show depths.

GROUND LEVEL

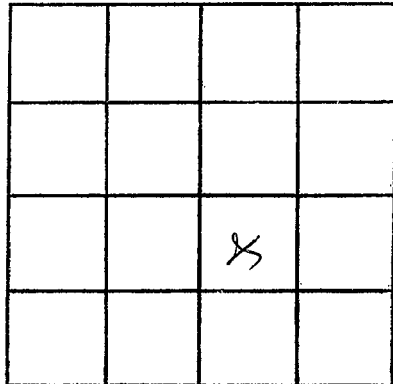

SECTION 12

Please indicate well location X.

ADDITIONAL INFORMATION

If more than one screen, show locations of each on sketch.