

MISSISSIPPI DEPARTMENT OF NATURAL RESOURCES

Bureau of Land and Water Resources

Southport Mall

P.O. Box 10631

Jackson, Mississippi 39209

WATER WELL DRILLERS LOG

CODED

Yazoo
01077
7-14-81

July 14 1981 date well completed
 Larry's well's pump firm name
 Yazoo county well located

LANDOWNER:	description of formations encountered	from	to
Dixie Farms			
Latonia, Mo (mailing address)	CLAY MED & COARSE SAND	0 80	80 124

WELL LOCATION:
 sec. 5 T. 9 N. R. 4
9 miles SW of Latonia
 (distance) (direction) (nearest town)

WELL PURPOSE: irrigation
 (home, irrigation, municipal, industrial)

CODED

- WELL COMPLETION DATA:
- (1) diameter (inches) 16"
 - (2) total depth (feet) 124'
 - (3) static water level (feet) 14 below above top of ground.
 - (4) casing Steel, 84'
 (material) (depth)
 (size) if telescope see back.
 - (5) screen 40', 84'
 (length) (depth to top)
16", Steel
 (size) (material)
 - (6) pump 60, 3000
 (HP) (yield gpm)
 (type power)
 - (7) electric log No
 (yes or no)
 (organization running log)
 - (8) how well bottom plugged Steel Plate


DRILLERS REMARKS:

DEPT. OF NATURAL RESOURCES
 BUREAU OF LAND & WATER RESOURCES

OCT 19 1981
 RECEIVED

If well telescopes please sketch and show depths.

GROUND LEVEL

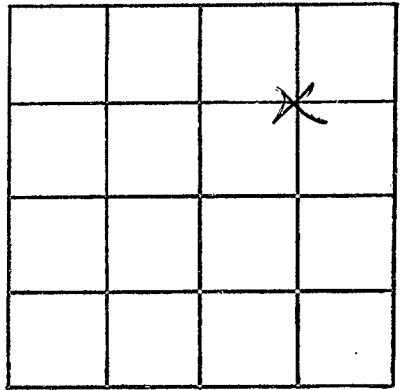

SECTION 6

Please indicate well location X.

ADDITIONAL INFORMATION

A series of 18 horizontal lines providing space for additional information.

If more than one screen, show locations of each on sketch.