

MISSISSIPPI DEPARTMENT OF NATURAL RESOURCES

Bureau of Land and Water Resources

Southport Mall

P.O. Box 10631

Jackson, Mississippi 39209

WATER WELL DRILLERS LOG

CODED

Yazoo
7P-79
7-15-81

July 15 1981 date well completed
Larry's well & pump firm name
Yazoo county/well located

LANDOWNER: <u>Dixie Farms</u>	description of formations encountered	from	to
<u>Datonia Ms</u> (mailing address)	<u>CLAY</u> <u>FINE SAND</u> <u>COARSE SAND</u>	<u>0</u> <u>35</u> <u>65</u>	<u>35</u> <u>65</u> <u>105</u>
WELL LOCATION: sec. <u>6</u> T. <u>9</u> N. R. <u>4</u> E <u>9</u> miles <u>SW</u> of <u>Datonia</u> (distance) (direction) (nearest town)			
WELL PURPOSE: <u>Drinking</u> (home, irrigation, municipal, industrial)			
WELL COMPLETION DATA:			
(1) diameter (inches) <u>16"</u>			
(2) total depth (feet) <u>105'</u>			
(3) static water level (feet) <u>13</u> <u>below</u> top of ground.			
(4) casing <u>STEEL</u> , <u>65'</u> (material) (depth)			
_____ if telescope see back. (size)			
(5) screen <u>40"</u> , <u>65'</u> (length) (depth to top)			
_____ <u>STEEL</u> (size) (material)			
(6) pump <u>60</u> , <u>300</u> (HP) (yield gpm)			
_____ (type power)			
(7) electric log <u>No</u> (yes or no)			
_____ (organization running log)			
(8) how well bottom plugged <u>steel</u> <u>plate</u>			
DRILLERS REMARKS:			

CODED

DEPT. OF NATURAL RESOURCES
BUREAU OF LAND & WATER RESOURCES


OCT 19 1981

RECEIVED

②

If well telescopes please sketch and show depths.

GROUND LEVEL

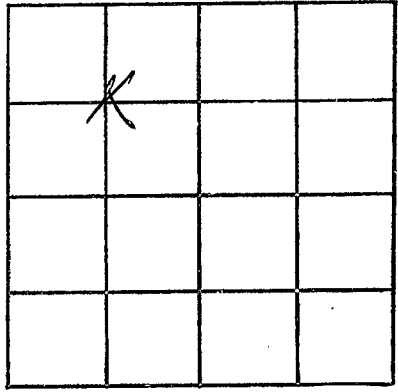

SECTION 6

Please indicate well location X.

ADDITIONAL INFORMATION

Lined area for additional information.

If more than one screen, show locations of each on sketch.