

MISSISSIPPI DEPARTMENT OF NATURAL RESOURCES

Bureau of Land and Water Resources

Southport Mall

P.O. Box 10631

Jackson, Mississippi 39209

WATER WELL DRILLERS LOG

CODED

Aug. 6 1984 E.M. Bud "CRESSWELL" Yards
 date well completed firm name county well located

LANDOWNER:
 Hyman J. Jansen
 Sartain Ms. 39162
 (mailing address)

description of formations encountered	from	to
Clay	0	40
sand pump	40	130
Clay	130	360
sandy-shale	360	460
sand	460	730

WELL LOCATION:
 sec. 24 T. 9 N R. 4 E
 4 miles West of Sartain
 (distance) (direction) (nearest town)

WELL PURPOSE: Home
 (home, irrigation, municipal, industrial)

WELL COMPLETION DATA:

(1) diameter (inches) 4

(2) total depth (feet) 570

(3) static water level (feet) 10 below top of ground.

(4) casing PVC 54 (material), (depth), 4 (size) if telescope see back.

(5) screen 30 570 (length), (depth to top) 2 PVC (size), (material)

(6) pump 1 25 (HP), (yield gpm)

(type power)

(7) electric log No (yes or no)

(organization running log)

(8) how well bottom plugged half Wash valve

CODED


DRILLERS REMARKS:

DEPT. OF NATURAL RESOURCES
 BUREAU OF LAND & WATER RESOURCES

AUG 7 1984
 RECEIVED

If well telescopes please sketch and show depths.

GROUND LEVEL

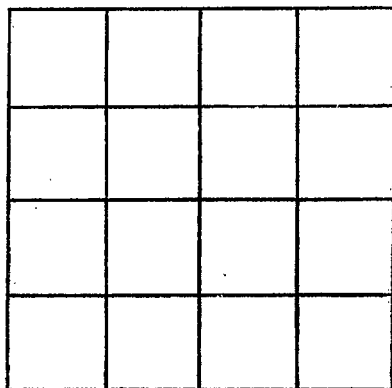

SECTION _____

Please indicate well location X.

ADDITIONAL INFORMATION

If more than one screen,
show locations of each on sketch.