

MISSISSIPPI DEPARTMENT OF NATURAL RESOURCES

Bureau of Land and Water Resources

Southport Mall

P.O. Box 10631

Jackson, Mississippi 39209

WATER WELL DRILLERS LOG

Yazoo
488

Weld

April 25 1988 E.M. Bud Renewell Yazoo
date well completed firm name county well located

LANDOWNER:	description of formations encountered	from	to
<u>MORRISON Enterprises</u> <u>Dixie Farms, No. 39162</u> <u>Sartoria</u> (mailing address)	<u>Glumbo</u> <u>band - gravel</u>	<u>0</u>	<u>40</u> <u>40</u> <u>110</u>

WELL LOCATION:
sec. 5 T. 9 N R. 4 W
4 miles SW of SARTORIA
(distance) (direction) (nearest town)

WELL PURPOSE: Irrigation
(home, irrigation, municipal, industrial)

- WELL COMPLETION DATA:
- (1) diameter (inches) 6
 - (2) total depth (feet) 110
 - (3) static water level (feet) 20 below top of ground.
 - (4) casing PVC 70
(material) (depth)
6 if telescope see back.
(size)
 - (5) screen 40 70
(length) (depth to top)
6 PVC
(size) (material)
 - (6) pump 5 80
(HP) (yield gpm)
(type power)
 - (7) electric log no
(yes or no)
(organization running log)
 - (8) how well bottom plugged cap

RECEIVED


MAY 5 1988

Dept. of Natural Resources
Bureau of Land & Water Resources

DRILLERS REMARKS:
MSFWP-08264

If well telescopes please sketch and show depths.

GROUND LEVEL

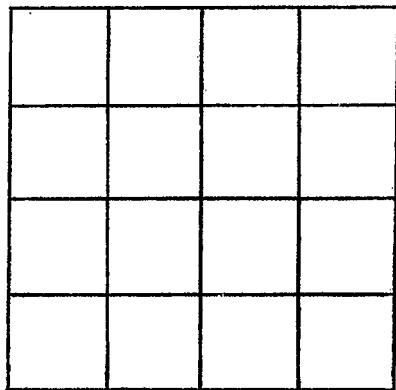

SECTION _____

Please indicate well location X.

ADDITIONAL INFORMATION

If more than one screen,
show locations of each on sketch.