State Well Report					
County: Yazoo	Part 1 For Office Use Only:		For Office Use Only:		
Permit #:	Mississippi Department of Environmental Quality		Aquifer:		
Irrigation Equipment		Office of Land and Water Resources			
Driller: 8-13-04	P.O. Box 10631 Well #: 26 - 7 5 Jackson, MS 39289-0631 I. S. Flavetion:				
Date drilling completed:		961-5210	L. S. Elevation:		
		4-6938 (fax)	E-log #:		
State Law requires that this report be prepared by the driller in detail and filed with the Department within					
30 days of completion of drilling	of the well.	driller in detail and filed w	ith the Department within		
Well Owner Information Well Location					
Owner Name Dixie farms			" Longitude: 30 W		
Box 188		Laumde:	"Longitude:'		
Mailing Address:	· · · · · · · · · · · · · · · · · · ·	Method of Lat/Long (circle on	e): Conventional Survey,		
		USGS med Ward hold	GPS, Survey-grade GPS		
Jackson, MS	39205		// * /		
		NE 4 SE 4 Sec 19	Twn 1910 Rng 4W		
City Sta	te Zip Code	SE NE Distance Direction	Nearest Town		
Telephone No. () Contact Person: Larr		8 Miles SW	of Satartia		
Contact Person: Larr					
•	Well I	Pata	Wildlife		
Purpose of Well (circle one) Home Ind	ustrial Public Supply	Irrigation Fish Culture	Management		
Date well drilling started: 8-13-04 Date well drilling completed: 8-13-04					
If flowing, method of flow regulation: Val	veOther (d	escribe)			
If flowing, method of flow regulation: Valve Other (describe) Static Water Level:10ft feet above or below circle one) land surface Date measured:8-16-04					
Method of Measurement (circle one) seel tape electric tape air line other:					
Hole depth: 96' Well depth: 96' Well grouted to a depth of 10 feet					
Type of grout (circle one): Cement Bentonite Mix					
Casing length: 66 feet Casin	ng diameter: 16	inches Type of casing:	PVC Sch.40		
Screen length: 30 feet Screen	en diameter: 16	inches Type of screen: _F	PVC Sch.40		
Screen slot size:	Setting depth: Prom_	67feet to	96 feet		
Type of completion (circle ail applicable): Tavel packed Underreamed Telescoped Open hole Natural Development					
Other (describe):					
Top of lap pipe or reduction in casing:feet. If telescoped or more than one screen, describe on back of page					
Logs run (circle all applicable) No log run Electric Gamma Ray Density Sonic Neutron Other:					
Name of organization running log(s):					
I certify that the well was drilled, constr	ucted, and completed in	eccordance with all applicable	requirements of the Mississippi		
Department of Environmental Quality a	nd/or the Mississippi Dep	partment of Health regulations	and state laws.		
Irrigation Equipment Inc.					
Patrick M. Chism 0695 Tathih M Chism					

Print Name of Water Well Contractor and License No.


Signature of Water Well Contractor

RECEIVED

Ground	Level

Description of Formations Encountered	From	To
Clav	0	38
Fine Sand/gravel Med. Sand/gravel	39	65
Med. Sand/gravel	66	92
Clay	93	96
		
	1	
	<u> </u>	
	<u> </u>	
	1	
		$ldsymbol{ldsymbol{ldsymbol{eta}}}$
	1	11
		1
		11
	<u> </u>	
		1_1
	1	
		1

If more than one screen, show location of each on sketch

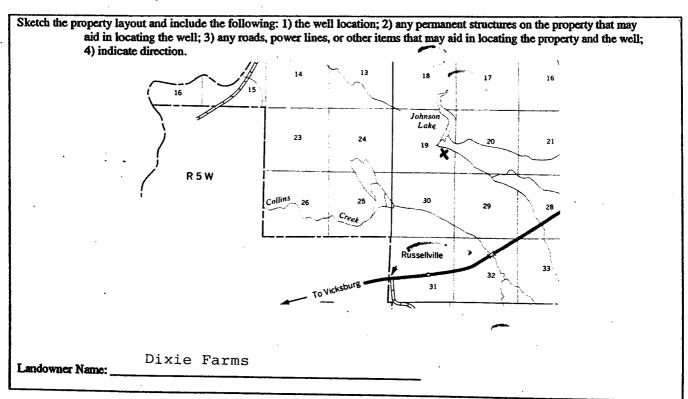

Fatrick M Chisan Signature of Water Well Contractor

STATE WELL REPORT

Part 2

Pump Installer's Completion Report
Mississippi Department of Environmental Quality
Office of Land and Water Resources
P.O. Box 10631
Jackson, MS 39289-0631
(601)961-5210
(601)354-6938 (fax)

For Office Use Only:		
Aquif	er:	
Well	#. <u>U-9</u> 5	
Eleva	tion:	

This report should be prepared by the pump installer in detail and filed with the Department within 30 days of the installation of pump.

Yazoo

Irrigation Equipment

8-16-04

County:

Permit #:

Driller:

Date completed:

installation of pump.	a and med with the Department within 30 days of the	
Well Owner Information	Well Location	
Owner Name: Dixie Farms	Latitude: Longitude:	
Mailing Address: Box 188	Method of Lat/Long (circle one): Conventional Survey,	
Jackson, MS 39205 City State Zip Code Telephone No.() Contact Person: Larry Vance	USGS quad, Hand-held GPS, Survey-grade GPS NE 1/4 SE 1/4 Sec 19 Twn 19N Rng 4W Distance Direction Nearest Town 8 SW Satartia Miles SW of	
Pump Type Circle one	Power Type Circle one	
Air Lift Jet Submersible	Liesel Engine Gasoline Engine Natural Gas	
Bucket Piston Curbine	Electric Motor Hand Tractor PTO	
Centrifugal Rotary Flowing Well	Windmill Other (specify):	
Other (specify):	Horse Power Rating of Motor:	
Date Pump Installed: 8-16-04	Setting Depth:feet	
2500-3000 Rated Pump Capacity:Gallons Per Minute	Number of Stages: 1	
Pump Test Data Date Well Tested:	Method of Measuring Water Level Circle one	
Static Water Level (A): 10 Feet Below Land Surface	Air Line Electric Measuring Line Steel Tape	
Pumping Water Level (B):Feet Below Land Surface	Other (specify):	
Drawdown [(B) – (A)]:Feet Below Land Surface	For flowing well, measured shut in head:feet	
Test Pumping Rate:Gallons Per Minute ~	Well yieldedGPM with a drawdown of	
Duration of Pump Test (minimum 4 hours):hours	feet afterhours of pumping	

I HEREBY CERTIFY that the above statements are true to the best of my knowledge

0695

Patrick M. Chism

Print Name of Pump Installer and License No. (if applicable)

Signature of Pump Installer RECEIVED