

YAZOO
 U 98
 3-22-77
 E Log # 274

MISSISSIPPI
 BOARD OF WATER COMMISSIONERS
 416 North State Street
 Jackson, Mississippi 39201

CODED

WATER WELL DRILLERS LOG

March 22 1977 E.M. "Bud" CRESSWELL YAZOO
 date well completed firm name county well located

LANDOWNER:
 Mrs. E. Smith
 SATARTIA, MS.
 (mailing address)

description of formations encountered	from	to
Clay	0	15
Sand	15	140
Clay	140	460
Shale - Shale	460	630
Shale	630	740
Shale	740	800

WELL LOCATION:
 sec. 19 T 9 N R 4 E
 3 miles S of Satartia
 (distance) (direction) (nearest town)

WELL PURPOSE: home
 (home, irrigation, municipal, industrial)

- WELL COMPLETION DATA:
- (1) diameter (inches) 4
 - (2) total depth (feet) 800
 - (3) static water level (feet) 30 below top of ground.
 - (4) casing Steel 1780 (material) (depth)
 4 (size) If telescope see back.
 - (5) screen 20 780 (length) (depth to top)
 2 (size) STAINLESS (material)
 - (6) pump 1 1/2 40 (HP) (yield gpm)
 0 (type power)
 - (7) electric log yes (yes or no)
 State (organization running log)
 - (8) how well bottom plugged steel plug

CODED


DRILLERS REMARKS:

REGISTERED
 APR 12 1977

MISS. RD. OF WATER COM.

If well telescopes please sketch and show depths.

GROUND LEVEL

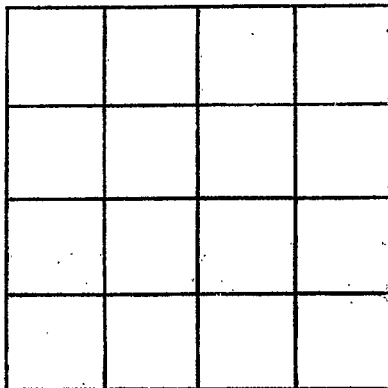

SECTION _____

Please indicate well location X.

ADDITIONAL INFORMATION

If more than one screen, show locations of each on sketch.