

State Well Report

Part 1

Mississippi Department of Environmental Quality
Office of Land and Water Resources
P.O. Box 10631
Jackson, MS 39289-0631
(601)961-5210
(601)354-6938 (fax)

For Office Use Only:

Aquifer: _____

Well #: U108

L. S. Elevation: _____

E-log #: _____

County: Y9200
Permit #: _____
Irrigation Equipment
Driller: _____
Date drilling completed: 6-13-09

State Law requires that this report be prepared by the driller in detail and filed with the Department within 30 days of completion of drilling of the well.

Well Owner Information	Well Location
Owner Name: <u>Eagle Creek Land Management</u>	Latitude: <u>32° 39' 26"</u> Longitude: <u>90° 38' 58"</u>
Mailing Address: <u>Box 259</u>	Method of Lat/Long (circle one): Conventional Survey, USGS quad, Hand-held GPS, Survey-grade GPS
<u>Mer Rouge Lg. 71261</u> City State Zip Code	<u>SE 1/4 NW 1/4 Sec 6</u> Twn <u>9N</u> Rng <u>4W</u>
Telephone No. () _____	Distance Direction Nearest Town <u>6</u> Miles <u>SW</u> of <u>Sartoria</u>
Well Data <u>Old Well 16" Steel 25' North</u>	
Purpose of Well (circle one) Home Industrial Public Supply <u>Irrigation</u> Fish Culture <u>Other</u> <u>Replacement</u>	
Date well drilling started: <u>6-13-09</u> Date well drilling completed: <u>6-13-09</u>	
If flowing, method of flow regulation: Valve _____ Other (describe) _____	
Static Water Level: <u>11</u> feet above of <u>below</u> (circle one) land surface Date measured: <u>6-17-09</u>	
Method of Measurement (circle one) <u>steel tape</u> electric tape air line other: _____	
Hole depth: <u>117</u> Well depth: <u>117</u> Well grouted to a depth of <u>10</u> feet	
Type of grout (circle one): Cement <u>Bentonite</u> Mix	
Casing length: <u>97</u> feet Casing diameter: <u>16</u> inches Type of casing: <u>PVC</u>	
Screen length: <u>20</u> feet Screen diameter: <u>16</u> inches Type of screen: <u>PVC</u>	
Screen slot size: <u>.050</u> inches Setting depth: From <u>98</u> feet to <u>117</u> feet	
Type of completion (circle all applicable): <u>Gravel packed</u> Underreamed Telescoped Open hole Natural Development	
Other (describe): _____	
Top of lap pipe or reduction in casing: _____ feet. If telescoped or more than one screen, describe on back of page	
Logs run (circle all applicable): <u>No log run</u> Electric Gamma Ray Density Sonic Neutron Other: _____	
Name of organization running log(s): _____	
I certify that the well was drilled, constructed, and completed in accordance with all applicable requirements of the Mississippi Department of Environmental Quality and/or the Mississippi Department of Health regulations and state laws.	
Irrigation Equipment Inc. John P. Chism 0439	
Print Name of Water Well Contractor and License No.	<u>John P. Chism</u> Signature of Water Well Contractor

RECEIVED

JUN 29 2009

BY: OLWR

If well telescopes please sketch below and show depths.

Ground Level

Description of Formations Encountered	From	To
Clay	0	52
Fine Sand	53	71
Fine Sand + Gravel	72	93
Medium Sand + Gravel	94	115
Clay	116	117

If more than one screen, show location of each on sketch

Sketch the property layout and include the following: 1) the well location; 2) any permanent structures on the property that may aid in locating the well; 3) any roads, power lines, or other items that may aid in locating the property and the well; 4) indicate direction.

Landowner Name: Eagle Creek Land Management

Jamie Q
Signature of Water Well Contractor

RECEIVED
JUN 29 2003
BY: OLWR

STATE WELL REPORT

Part 2

Pump Installer's Completion Report
 Mississippi Department of Environmental Quality
 Office of Land and Water Resources
 P.O. Box 10631
 Jackson, MS 39289-0631
 (601)961-5210
 (601)354-6938 (fax)

County: Yazoo
 Permit #: _____
 Irrigation Equipment
 Driller: _____
 Date completed: 6-13-09

For Office Use Only:

Aquifer: _____
 Well #: U.108
 Elevation: _____

This report should be prepared by the pump installer in detail and filed with the Department within 30 days of the installation of pump.

Well Owner Information	Well Location
Owner Name: <u>Eagle Creek Land Mgt.</u>	Latitude: <u>32°39'26"</u> Longitude: <u>90°38'58"</u>
Mailing Address: <u>Box 259</u>	Method of Lat/Long (circle one): Conventional Survey,
<u>Mer Rouge La. 71261</u>	USGS quad, Hand-held GPS, Survey-grade GPS
City State Zip Code	<u>SE 1/4 NW 1/4 Sec 6 Twn 9N Rng 4W</u>
Telephone No. () _____	Distance Direction Nearest Town
	<u>6 Miles SW of Sartantia</u>

Pump Type Circle one	Power Type Circle one
Air Lift Jet Submersible	<u>Diesel Engine</u> Gasoline Engine Natural Gas
Bucket Piston <u>Turbine</u>	Electric Motor Hand Tractor PTO
Centrifugal Rotary Flowing Well	Windmill Other (specify): _____
Other (specify): _____	Horse Power Rating of Motor: <u>100</u>
Date Pump Installed: <u>6-17-09</u>	Setting Depth: <u>80</u> feet
Rated Pump Capacity: <u>3000±</u> Gallons Per Minute	Number of Stages: <u>2</u>


Pump Test Data	Method of Measuring Water Level Circle one
Date Well Tested: _____	Air Line Electric Measuring Line Steel Tape
Static Water Level (A): _____ Feet Below Land Surface	Other (specify): _____
Pumping Water Level (B): _____ Feet Below Land Surface	For flowing well, measured shut in head: _____ feet
Drawdown [(B) - (A)]: _____ Feet Below Land Surface	Well yielded _____ GPM with a drawdown of
Test Pumping Rate: _____ Gallons Per Minute	_____ feet after _____ hours of pumping
Duration of Pump Test (minimum 4 hours): _____ hours	

I HEREBY CERTIFY that the above statements are true to the best of my knowledge.

John P. Chism 0439
 Print Name of Pump Installer and License No. (if applicable)

John P. Chism
 Signature of Pump Installer

RECEIVED
 JUN 29 2009
 BY: OLWR

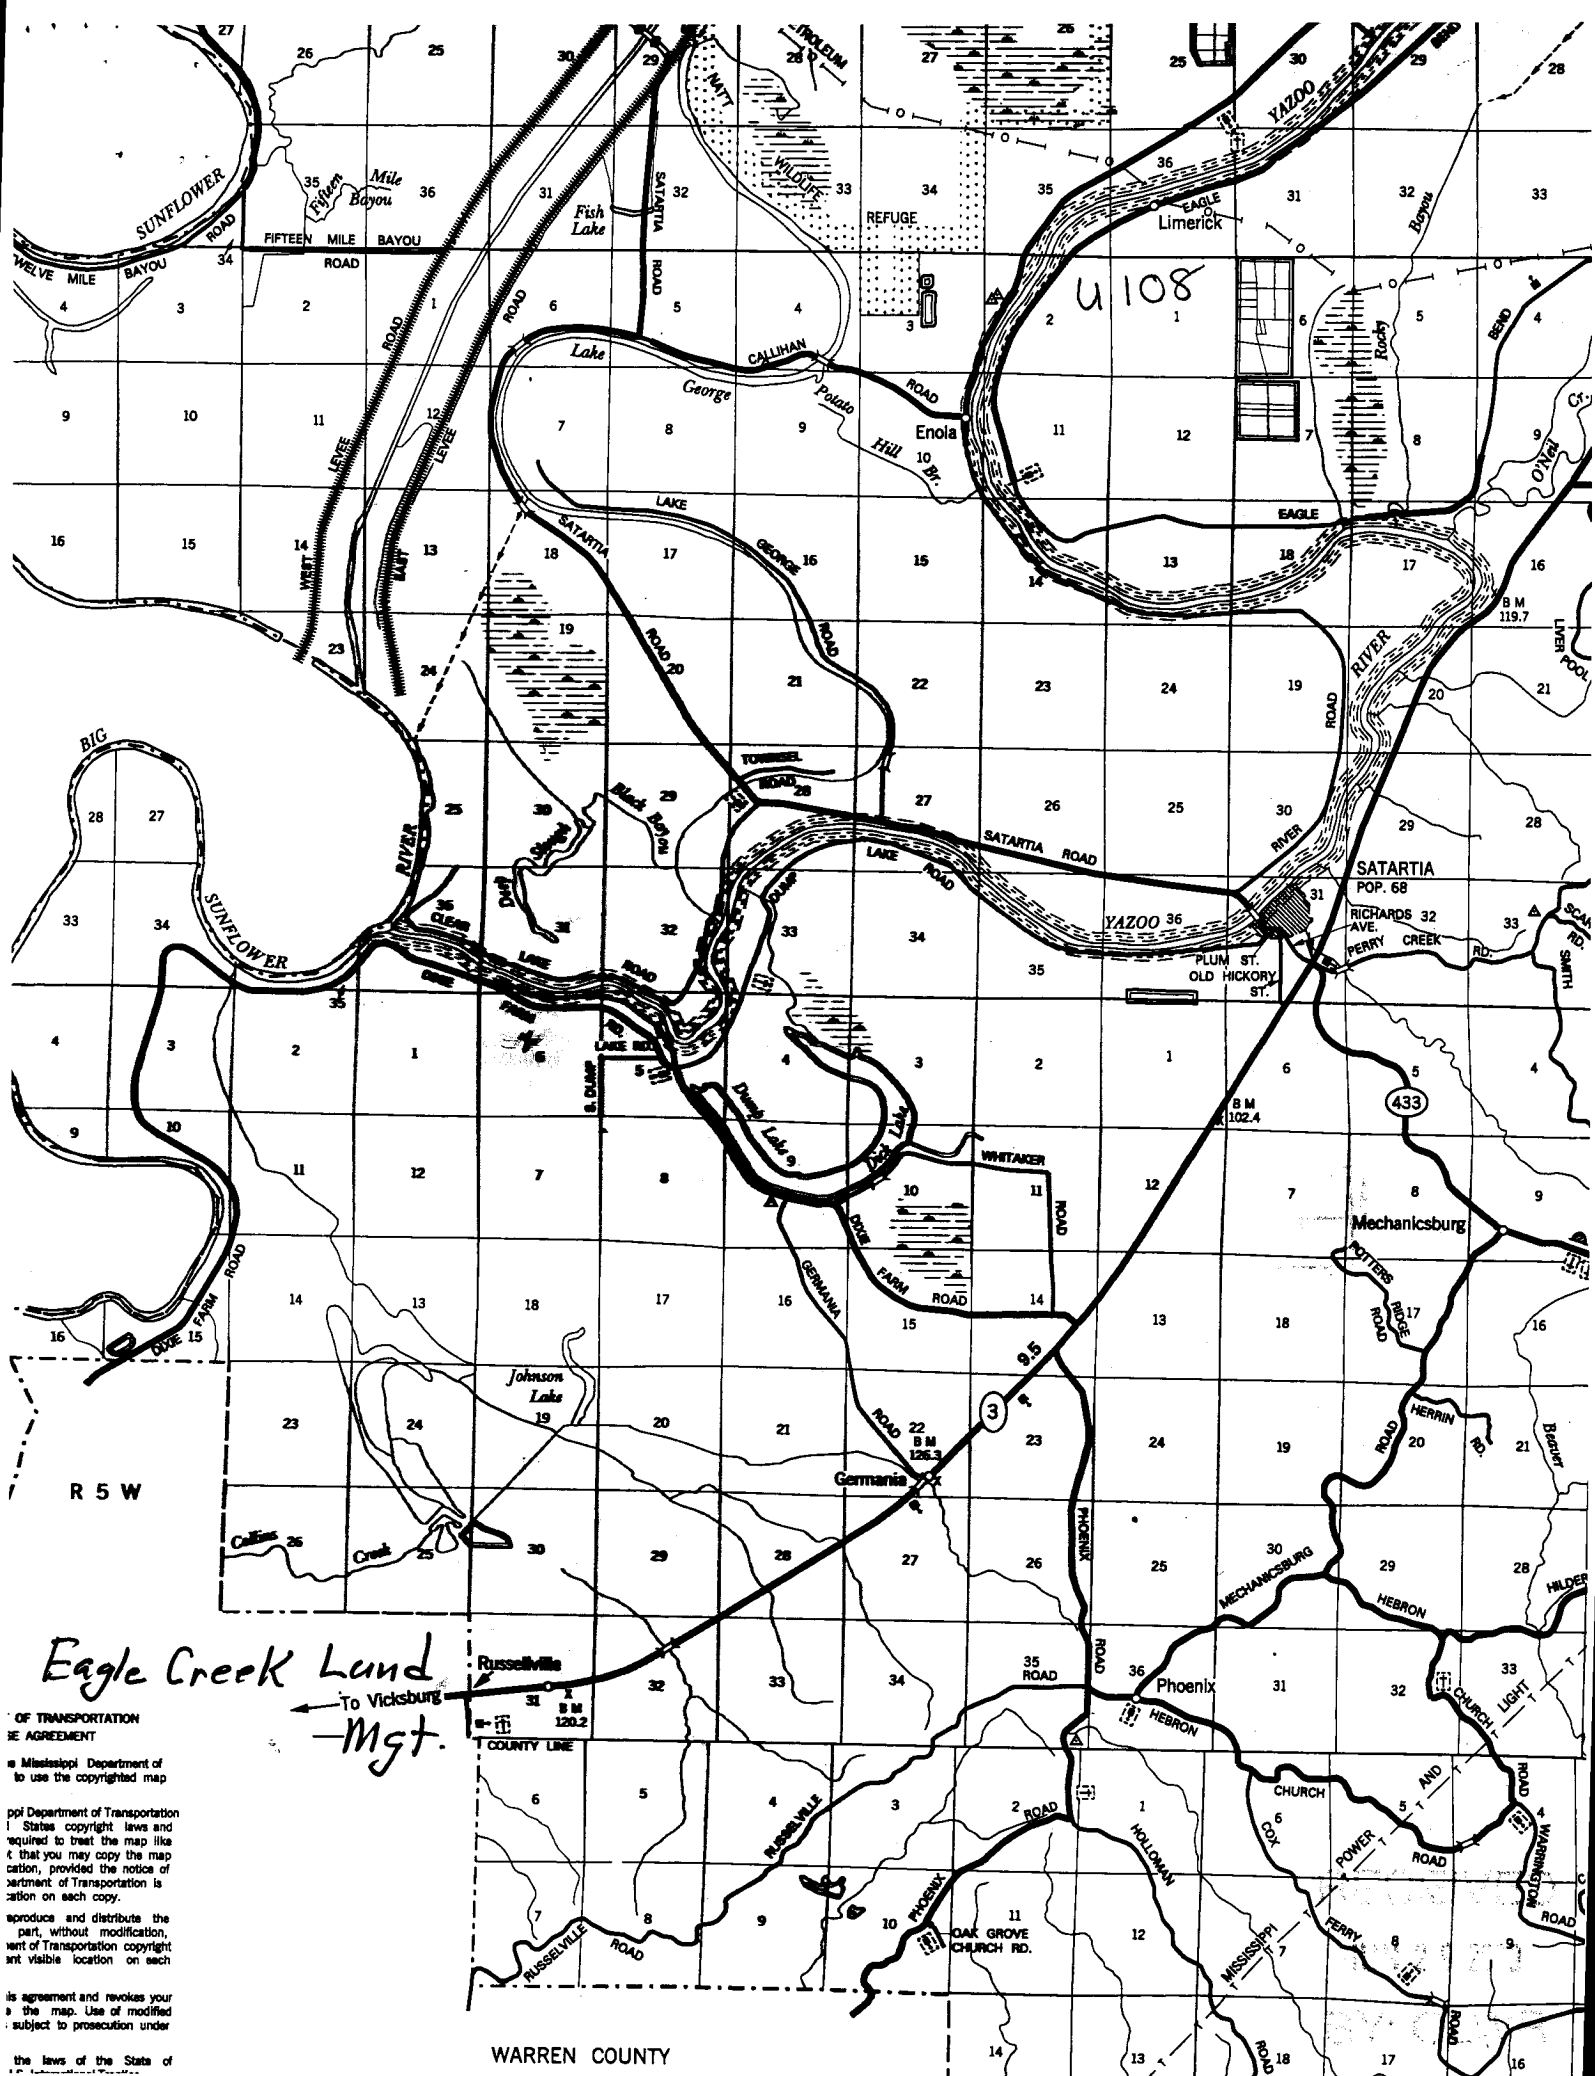

*Eagle Creek Land
Mgt.*

OF TRANSPORTATION
SE AGREEMENT

Mississippi Department of
to use the copyrighted map

Department of Transportation
States copyright laws and
required to treat the map like
that you may copy the map
caption, provided the notice
Department of Transportation is
caption on each copy.

reproduce and distribute the
part, without modification,
Department of Transportation copyright
ent visible location on each

is agreement and revokes your
the map. Use of modified
subject to prosecution under

the laws of the State of

WARREN COUNTY