

YAZOO
U 2000
8-15-62

WATER WELL DRILLERS LOG

Date: Aug 15, 1962, Driller: J. H. Barnes County YAZOO
(Name)

(1) Owner of Land: John Harmon
(Name)
SATARTIA Rt-1
(Address)

(2) Location: N-W 1/4, S-W 1/4, Sec. 27 T9N R4W
6 miles South, of SATARTIA,
(distance) (direction) (Nearest Town)

(3) Topography: FLAT
(Hilly) (Flat) (Level)

(4) Purpose of Well: FARM
(Domestic Irrigation
Municipal, Industrial, Other)

Description & Color of Materials Sand, Clay, Red Clay, Shell, etc.	Thick- ness Feet	Depth Feet
<u>Dark Sand Layer</u>	<u>10</u>	<u>10</u>
<u>Sand + Gravel</u>	<u>20</u>	<u>30</u>
<u>Blue Shell +</u>	<u>520</u>	<u>560</u>
<u>Dark Shell</u>	<u>140</u>	<u>700</u>
<u>water sand</u>		
		<u>700</u>

Information upon completion of well:

(1) Diameter 2 inches.

(2) Total Depth 700 feet.

(3) Water Level 20 feet below top of ground.

(4) Cased to 680, Size 2"


(5) Screen: Size 006, Length 20

(6) Were any formations sealed against pollution?
_____ yes, _____ no.

If YES depth of formation _____

Why _____

Drillers Remarks: _____

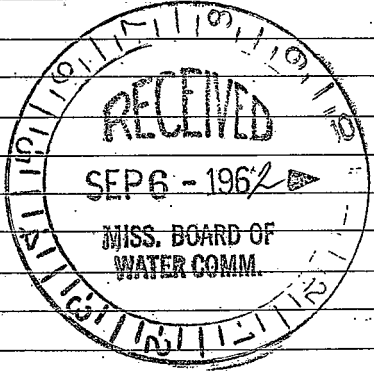

(Use Back Side)

Well No.

