

YAZOO

U: 2009

04-15-79

MISSISSIPPI BOARD OF WATER COMMISSIONERS 416 North State Street Jackson, Mississippi 39201

WATER WELL DRILLERS LOG

4-15

date well completed

1979 Larry's Well Pump Co.

firm name

Yazoo

county well located

LANDOWNER: Dixie Farms

Jackson Miss.

(mailing address)

WELL LOCATION:

sec. 14 T 9 N R E 4 W S 5 W

3 mi S miles 3 mi W of Jackson (distance) (direction) (nearest town)

WELL PURPOSE: Irrigation (home, irrigation, municipal, industrial)

WELL COMPLETION DATA:

- (1) diameter (inches) 16"
(2) total depth (feet) 107'
(3) static water level (feet) 9 below top of ground.
(4) casing steel 67' (material) (depth)
(5) screen 20' 67' (length) (depth to top) 16" steel (size) (material)
(6) pump 90 3000 (HP) (yield gpm)
D (type power)
(7) electric log no (yes or no)

(organization running log)

(8) how well bottom plugged steel plate

DRILLERS REMARKS:

description of formations encountered

from to

Table with 3 columns: description of formations encountered, from, to. Contains handwritten entries: Clay, F sand, fine dark sand, fine sand, coarse sand with depth ranges 0-20, 20-30, 30-45, 45-60, 60-107.


Miss. Board of Water Comm.

MAY 7 1979

RECEIVED

If well telescopes please sketch and show depths.

GROUND LEVEL

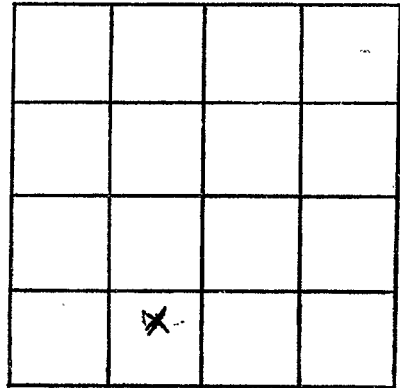

SECTION 14

Please indicate well location X.

ADDITIONAL INFORMATION

If more than one screen,
show locations of each on sketch.