

Y 4200  
5 V 11

WATER WELL DRILLERS LOG

**CODED**

Date: 9-21-63 1963, Driller: CREEI AND CRESSWELL County: YAZOO  
(Name)

4438

- (1) Owner of Land: LAMAR SIDLEY  
(Name)
- BENTONIA  
(Address)
- (2) Location: 1/4, 1/4, Sec. 20 T. 9 R. 3W  
1.8 miles WEST, of BENTONIA,  
(distance) (direction) (Nearest Town)
- (3) Topography: HILLY  
(Hilly) (Flat) (Level)
- (4) Purpose of Well: DOMESTIC  
(Domestic Irrigation  
Municipal, Industrial, Other)


Description & Color of Materials Sand, Clay, Red Clay, Shell, etc.	Thick- ness Feet	Depth Feet
<u>RED CLAY</u>	<u>80</u>	<u>80</u>
<u>BLUE CLAY ROCK</u>	<u>50</u>	<u>130</u>
<u>BLUE CLAY</u>	<u>300</u>	<u>430</u>
<u>MUDY BRANCH</u>	<u>30</u>	<u>460</u>
<u>SPY SHALE</u>	<u>200</u>	<u>660</u>
<u>SAND FINE</u>	<u>30</u>	<u>690</u>
<u>SAND AND SHALE</u>	<u>70</u>	<u>760</u>
<u>SAND</u>	<u>40</u>	<u>800</u>

Information upon completion of well:

- (1) Diameter 4 X 2 inches.
- (2) Total Depth 800 feet.
- (3) Water Level 230 feet below top of ground.
- (4) Cased to 780, Size ~~5 1/2~~
- (5) Screen: Size 008, Length 20'
- (6) Were any formations sealed against pollution?  
\_\_\_\_\_ yes, \_\_\_\_\_ no.

If YES depth of formation \_\_\_\_\_  
Why \_\_\_\_\_  
Drillers Remarks: \_\_\_\_\_

**CODED**

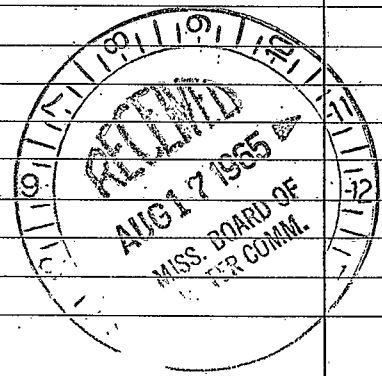

(Use Back Side)

Well No.

Retain this copy for your office files.

