

Yazoo Co
 V 15
 3-15-70

MISSISSIPPI
 BOARD OF WATER COMMISSIONERS
 416 North State Street
 Jackson, Mississippi 39201

WATER WELL DRILLERS LOG

3-15 1970 Lud Cresswell Yazoo
 date well completed firm name county well located

LANDOWNER:


Frank Worthy
Rt. 2, Benton, Miss.
 (mailing address)

description of formations encountered

from to

Clay	0	60
Sand	60	100
Sand-gravel	100	126

WELL LOCATION:

sec. 1 T. 9 R. 3 150

6 miles West Benton
 (distance) (direction) (nearest town)

WELL PURPOSE: Domestic
 (home, irrigation, municipal, industrial)

WELL COMPLETION DATA:

- (1) diameter (inches) 2
- (2) total depth (feet) 126
- (3) static water level (feet) 105 below above top of ground.
- (4) casing galv. 101
 (material) (depth)
2 if telescope see back.
 (size)
- (5) screen 5 101
 (length) (depth to top)
2" stainless
 (size) (material)
- (6) pump _____ (HP) _____ (yield gpm)
 _____ (type power)
- (7) electric log _____ (yes or no)
 _____ (organization running log)
- (8) how well bottom plugged _____


DRILLERS REMARKS:

APR 24 1970

MISS. BD. OF
 WATER COMMISSIONERS

If well telescopes please sketch and show depths.

GROUND LEVEL

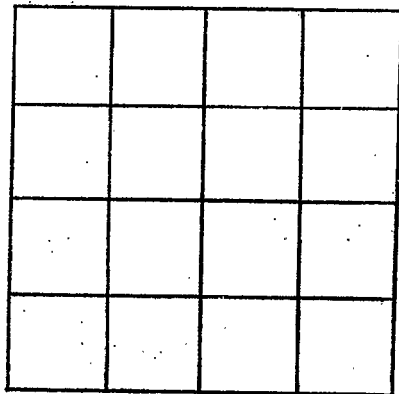

SECTION _____

Please indicate well location X.

ADDITIONAL INFORMATION

If more than one screen,
show locations of each on sketch.