

YAZOO
 V-19 CODED
 7-28-71

MISSISSIPPI
 BOARD OF WATER COMMISSIONERS
 416 North State Street
 Jackson, Mississippi 39201

CODED

WATER WELL DRILLERS LOG

7-28
 date well completed

71 E.M. "Bud" Cresswell
 firm name

Yazoo
 county well located

LANDOWNER:
 John Colburn
 Benton, Miss.
 (mailing address)

description of formations encountered	depth	
	from	to
Clay	0	60
sand	60	85

WELL LOCATION:
 sec. 30 T 9 N R. 3 E
 2 miles NE of Phenix
 (distance) (direction) (nearest town)

WELL PURPOSE: Domestic
 (home, irrigation, municipal, industrial)

- WELL COMPLETION DATA:
- (1) diameter (inches) 2
 - (2) total depth (feet) 85
 - (3) static water level (feet) 60 below top of ground.
 - (4) casing Steel 80 (material), (depth)
 2" (size) if telescope see back.
 - (5) screen 5 80 (length), (depth to top)
 2" (size), Stainless (material)
 - (6) pump 3/4 (HP) 5 (yield gpm)
 0 (type power)
 - (7) electric log No (yes or no)
 0 (organization running log)
 - (8) how well bottom plugged Steel plug

CODED


AUG 18 1971

MISS. BD. OF WATER COMM.

DRILLERS REMARKS:

If well telescopes please sketch and show depths.

GROUND LEVEL

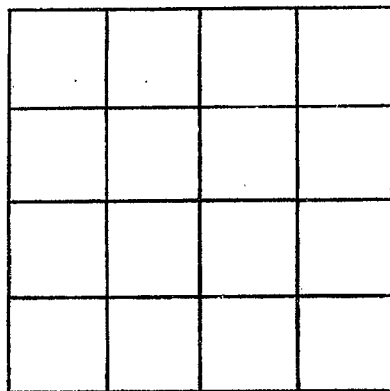

SECTION _____

Please indicate well location X.

ADDITIONAL INFORMATION

If more than one screen, show locations of each on sketch.