

CODED

YAZOO
V-20
8-18-71

MISSISSIPPI
BOARD OF WATER COMMISSIONERS
416 North State Street
Jackson, Mississippi 39201

CODED

WATER WELL DRILLERS LOG

8-18 1971 W. E. M. "Bud" Caswell Yazoo
date well completed firm name county well located

LANDOWNER:
W. O. Hilderbrand
Benton, Miss
(mailing address)

description of formations encountered	from	to
	<u>Clay</u>	<u>0</u>
<u>Bedrock</u>	<u>60</u>	<u>105</u>
<u>Blue clay</u>	<u>105</u>	<u>620</u>
<u>Shale</u>	<u>620</u>	<u>960</u>
<u>Sand</u>	<u>960</u>	<u>1040</u>

WELL LOCATION:
sec. 5 T. 8 N. R. 3 E.
4 miles SE of Phoenix
(distance) (direction) (nearest town)

WELL PURPOSE: Domestic
(home, irrigation, municipal, industrial)

- WELL COMPLETION DATA:
- (1) diameter (inches) 4 X 2
 - (2) total depth (feet) 1040
 - (3) static water level (feet) 180 below top of ground.
 - (4) casing Steel 1010
(material) (depth)
4 if telescope see back.
(size)
 - (5) screen 30 1010
(length) (depth to top)
2" stainless
(size) (material)
 - (6) pump 2 20
(HP) (yield gpm)
0
(type power)
 - (7) electric log P
(yes or no)
0
(organization running log)
 - (8) how well bottom plugged Steel plug

CODED


AUG 18 1971

MISS. BD. OF
WATER COMMISSIONERS

DRILLERS REMARKS:

If well telescopes please
sketch and show depths.

GROUND LEVEL

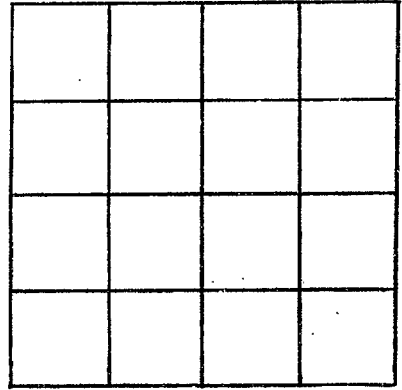

SECTION _____

Please indicate well location X.

ADDITIONAL INFORMATION

If more than one screen,
show locations of each on sketch.