

YAZOO
 V24
 10-19-71

MISSISSIPPI
 BOARD OF WATER COMMISSIONERS
 416 North State Street
 Jackson, Mississippi 39201

WATER WELL DRILLERS LOG

CODED
 YAZOO

Oct-19 1971
 date well completed

E.M. "Bud" Cresswell
 firm name

YAZOO
 county well located

LANDOWNER:
 Mr. S.L. Smith
 Benton, Miss.
 (mailing address)

description of formations encountered	from	to
clay	0	80
sand-gravel	80	131

WELL LOCATION:
 sec. 10 T. 9 N. R. 3 W.
 8 miles West of Benton
 (distance) (direction) (nearest town)

WELL PURPOSE: for residential
 (home, irrigation, municipal, industrial)

- WELL COMPLETION DATA:
- (1) diameter (inches) 2"
 - (2) total depth (feet) 131
 - (3) static water level (feet) 100 below top of ground.
 - (4) casing steel, 126 ft.
 (material) (depth)
2"
 (size) If telescope see back.
 - (5) screen 5 ft., 126 ft.
 (length) (depth to top)
2", stainless
 (size) (material)
 - (6) pump 1/2 3
 (HP) (yield gpm)
0
 (type power)
 - (7) electric log No
 (yes or no)
0
 (organization running log)
 - (8) how well bottom plugged
steel plug


CODED

DRILLERS REMARKS:

NOV 12 1971

If well telescopes please sketch and show depths.

GROUND LEVEL

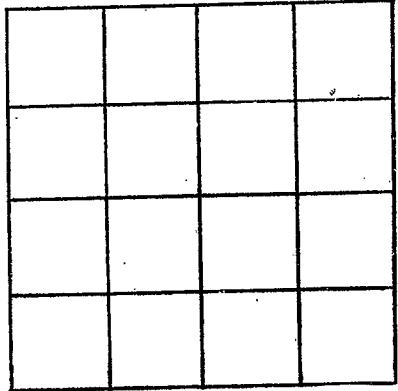

CODED

SECTION _____

Please indicate well location X.

ADDITIONAL INFORMATION

If more than one screen, show locations of each on sketch.