

MISSISSIPPI
BOARD OF WATER COMMISSIONERS
416 North State Street
Jackson, Mississippi 39201

WATER WELL DRILLERS LOG

YAZOO
V25
12-22-91

Dec. 22 1971 E.M. "Bud" Cresswell
date well completed firm name county well located

CODED

LANDOWNER:	description of formations encountered	from	to
W. J. SMITHART			
BENTONIA, Miss. (mailing address)	Sand	60	90
	Clay	90	680
	Shale	640	740
	Sand	740	800
<p>WELL LOCATION:</p> <p>sec. 14 T 9 N R 3 E 5 miles West of BENTONIA (distance) (direction) (nearest town)</p> <p>WELL PURPOSE: DOMESTIC (home, irrigation, municipal, industrial)</p> <p>WELL COMPLETION DATA:</p> <p>(1) diameter (inches) 2 X 4</p> <p>(2) total depth (feet) 800</p> <p>(3) static water level (feet) 190 below top of ground.</p> <p>(4) casing Steel 780 (material) (depth)</p> <p>2 (size) if telescope see back.</p> <p>(5) screen 20 780 (length) (depth to top)</p> <p>2 STAINLESS (size) (material)</p> <p>(6) pump 1 10 (HP) (yield gpm)</p> <p>0 (type power)</p> <p>(7) electric log YES (yes or no)</p> <p>STATE (organization running log)</p> <p>(8) how well bottom plugged Steel plug</p>			
DRILLERS REMARKS:			


CODED

JAN 12 1972

MISSISSIPPI
BOARD OF WATER COMMISSIONERS
416 NORTH STATE STREET
JACKSON, MISSISSIPPI 39201

If well telescopes please sketch and show depths.

GROUND LEVEL

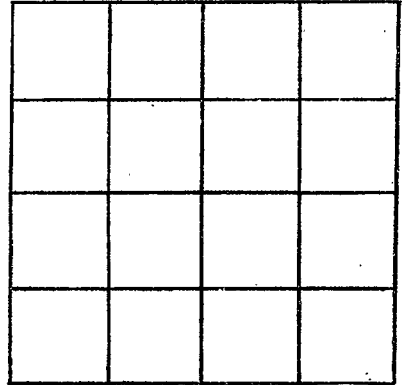

SECTION _____

Please indicate well location X.

ADDITIONAL INFORMATION

If more than one screen,
show locations of each on sketch.