

YAZOO
V 28
3-17-72

MISSISSIPPI
BOARD OF WATER COMMISSIONERS
416 North State Street
Jackson, Mississippi 39201

CODED

WATER WELL DRILLERS LOG

March 17 1972 E.M. "Bud" Russell Yazoo
date well completed firm name county well located

LANDOWNER:	description of formations encountered	from	to
Rail Bradshaw Benton, Miss. (mailing address)			
WELL LOCATION:			
sec. 15 T 9 N R 3 E 2 miles EAST of Mechanicsburg (distance) (direction) (nearest town)			
WELL PURPOSE: home (home, irrigation, municipal, industrial)			
WELL COMPLETION DATA:			
(1) diameter (inches) 2			
(2) total depth (feet) 110			
(3) static water level (feet) 70 below top of ground			
(4) casing steel 105 (material) (depth)			
2 (size) if telescope see back.			
(5) screen 5 105 (length) (depth to top)			
2 stainless (size) (material)			
(6) pump 3/4 5 (HP) (yield gpm)			
0 (type power)			
(7) electric log No (yes or no)			
0 (organization running log)			
(8) how well bottom plugged steel plug			
DRILLERS REMARKS:			


CODED

APR 6 1972

MISS. BD. OF WATER COMMISSIONERS

If well telescopes please sketch and show depths.

GROUND LEVEL

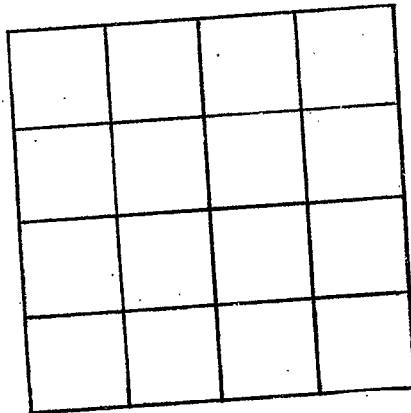

SECTION _____

Please indicate well location X.

ADDITIONAL INFORMATION

Lined area for additional information.

If more than one screen, show locations of each on sketch.