

YAZOO
 V 29
 4-27-73

MISSISSIPPI
 BOARD OF WATER COMMISSIONERS
 416 North State Street,
 Jackson, Mississippi 39201

CODED

WATER WELL DRILLERS LOG

April 27 1973 E.M. "Bud" Cresswell Yazoo
 date well completed firm name county well located

LANDOWNER:
 W.R. Hilderbrand Jr.
 BENTONIA, Miss.
 (mailing address)

description of formations encountered	from	to
	clay sand gravel	0 4.5

WELL LOCATION:
 sec 31 T 9 N R 3 E
 1 miles NE of Phenix
 (distance) (direction) (nearest town)

WELL PURPOSE: Home
 (home, irrigation, municipal, industrial)

WELL COMPLETION DATA:

- (1) diameter (inches) 2
- (2) total depth (feet) 80
- (3) static water level (feet) 60 below top of ground.
- (4) casing Steel 75 (material) (depth)
 2 (size) if telescope see back.
- (5) screen 5 75 (length) (depth to top)
 2 Stainless (size) (material)
- (6) pump 3/4 5 (HP) (yield gpm)
 0 (type power)
- (7) electric log No (yes or no)
 0 (organization running log)
- (8) how well bottom plugged
 Steel plug


CODED

APR 27 1973

DRILLERS REMARKS:

If well telescopes please
sketch and show depths.

GROUND LEVEL

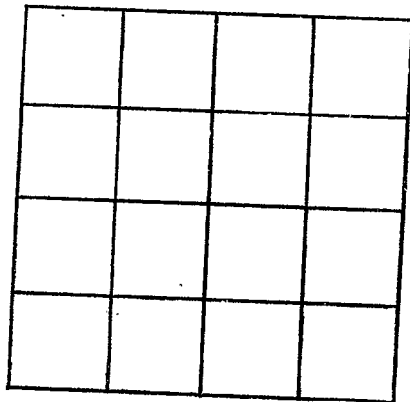

SECTION _____

Please indicate well location X.

ADDITIONAL INFORMATION

If more than one screen,
show locations of each on sketch.