

YAZOO
V31
1-3-74

MISSISSIPPI
BOARD OF WATER COMMISSIONERS
416 North State Street
Jackson, Mississippi 39201

CODED

WATER WELL DRILLERS LOG

Jan. 3 1974 E.M. "Bud" CRESSWELL YAZOO
date well completed firm name county well located

LANDOWNER:
W. E. TAIT
BENTONIA, Miss. 39040
(mailing address)

description of formations encountered	from	to
	CLAY	0
SAND - GRAVEL	60	110
SAND	110	140

WELL LOCATION:
sec. 18 T. 8 N R. 3 E
4 miles 5 of Phoenix
(distance) (direction) (nearest town)

WELL PURPOSE: Home
(home, irrigation, municipal, industrial)

- WELL COMPLETION DATA:
- (1) diameter (inches) 2
 - (2) total depth (feet) 140
 - (3) static water level (feet) 95 below top of ground.
 - (4) casing Steel, 130 (material), (depth), 2 (size) If telescope see back.
 - (5) screen 10, 130 (length), (depth to top), 2, STAINLESS (size), (material).
 - (6) pump 1 1/2, 5 (HP), (yield gpm), 0 (type power)
 - (7) electric log No (yes or no), 0 (organization running log)
 - (8) how well bottom plugged Steel plug

CODED


RECORDED
JAN 28 1974

DRILLERS REMARKS:

MISS. BD. OF WATER COMMISSIONERS

If well telescopes please sketch and show depths.

GROUND LEVEL

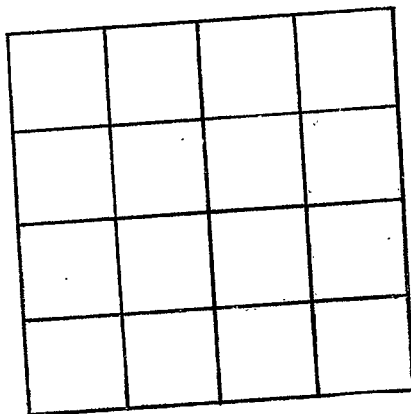

SECTION _____

Please indicate well location X.

ADDITIONAL INFORMATION

If more than one screen, show locations of each on sketch.