

YAZOO
V 34
10/16/74

MISSISSIPPI
BOARD OF WATER COMMISSIONERS
416 North State Street
Jackson, Mississippi 39201

CODED

WATER WELL DRILLERS LOG

Oct. 16 1974 E.M. "Bud" Cresswell YAZOO
date well completed firm name county well located

LANDOWNER:
Ben Johnson
BENTONIA, Miss.
(mailing address)

description of formations encountered	from	to
clay sand & gravel	0	55
	55	97

WELL LOCATION:
sec. 11 T 9 N R 3 E
6 miles West of BENTONIA
(distance) (direction) (nearest town)

WELL PURPOSE: Home
(home, irrigation, municipal, industrial)

CODED

WELL COMPLETION DATA:

(1) diameter (inches) 2

(2) total depth (feet) 97

(3) static water level (feet) 80 below above top of ground.

(4) casing Steel 92
(material) (depth)
2 if telescope see back.
(size)

(5) screen 5ft. 92
(length) (depth to top)
2" stainless
(size) (material)

(6) pump 3/4 5
(HP) (yield gpm)
0
(type power)

(7) electric log 0
(yes or no)
0
(organization running log)

(8) how well bottom plugged
plugged

DRILLERS REMARKS:


REGISTERED
LAW

OCT 22 1974

MISS. BO. OF WATER COMMISSIONERS

If well telescopes please sketch and show depths.

GROUND LEVEL

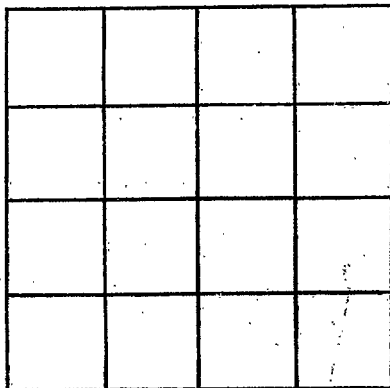

SECTION _____

Please indicate well location X.

ADDITIONAL INFORMATION

If more than one screen, show locations of each on sketch.