

YAZOO
V 35
1-20-75

MISSISSIPPI
BOARD OF WATER COMMISSIONERS
416 North State Street
Jackson, Mississippi 39201

CODED

WATER WELL DRILLERS LOG

Jan. 20 1975 F.M. "Bud" CRESSWELL YAZOO
date well completed firm name county well located

LANDOWNER:
John Sullivan
Spartan, Miss.
(mailing address)

description of formations encountered	from	to
Clay	0	60
Sand gravel	60	89

WELL LOCATION:
sec. 29 T9 N R 3 E W ?
1 miles E of Phoenix
(distance) (direction) (nearest town)

WELL PURPOSE: Home
(home, irrigation, municipal, industrial)


- WELL COMPLETION DATA:
- (1) diameter (inches) 2
 - (2) total depth (feet) 89
 - (3) static water level (feet) 60 below top of ground.
 - (4) casing Steel, 84 (material), (depth)
 - 2 (size) if telescope see back.
 - (5) screen 5, 84 (length), (depth to top)
 - 2, 84 (size), (material)
 - (6) pump 1, 5 (HP), (yield gpm)
 - 0 (type power)
 - (7) electric log No (yes or no)
 - 0 (organization running log)
 - (8) how well bottom plugged Steel plug

DRILLERS REMARKS:

RECEIVED
FEB 6 - 1975

If well telescopes please sketch and show depths.

GROUND LEVEL

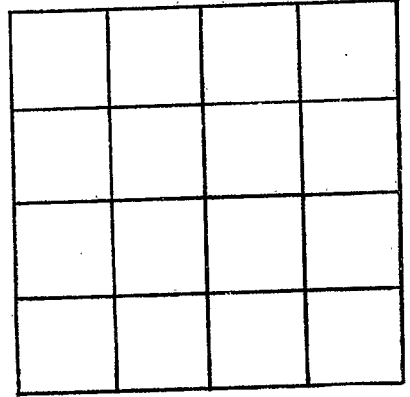

SECTION _____

Please indicate well location X.

ADDITIONAL INFORMATION

If more than one screen,
show locations of each on sketch.