

4200
 38
 8-26-75

MISSISSIPPI
 BOARD OF WATER COMMISSIONERS CODED
 416 North State Street
 Jackson, Mississippi 39201

WATER WELL DRILLERS LOG


Aug. 26 1975 E.M. "Bud" Cresswell 4200
 date well completed firm name county well located

| LANDOWNER: | description of formations encountered | from | to |
|---|---------------------------------------|------|----|
| D. V. Williams BENTONIA, MS. (mailing address) | | | |
| WELL LOCATION: sec. 11 T 9 N R 3 E 15 J 6 miles West of Bentonia (distance) (direction) (nearest town) | | | |
| WELL PURPOSE: none (home, irrigation, municipal, industrial) | | | |
| WELL COMPLETION DATA: (1) diameter (inches) 2 (2) total depth (feet) 110 (3) static water level (feet) 70 below top of ground. (4) casing Steel 10.5 (material) (depth) 2 (size) if telescope see back. (5) screen 5 10.5 (length) (depth to top) 2 Standen (size) (material) (6) pump 1 5 (HP) (yield gpm) 0 (type power) (7) electric log No (yes or no) (organization running log) (8) how well bottom plugged Steel plug | | | |
| DRILLERS REMARKS: | | | |

RECEIVED
 AUG 29 1975

If well telescopes please sketch and show depths.

GROUND LEVEL

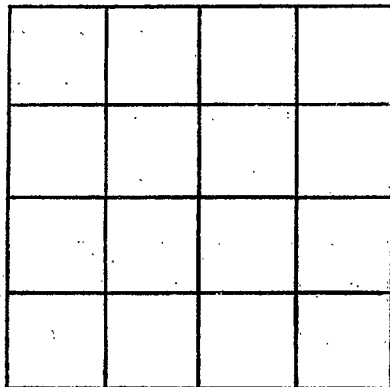

SECTION _____

Please indicate well location X.

ADDITIONAL INFORMATION

If more than one screen, show locations of each on sketch.