

Yazoo
 9/39
 8-25-75


MISSISSIPPI
 BOARD OF WATER COMMISSIONERS
 416 North State Street
 Jackson, Mississippi 39201

CODED

WATER WELL DRILLERS LOG


Aug. 25 1975 L.M. "Bud" CRESSWELL Yazoo
 date well completed firm name county well located

LANDOWNER:	description of formations encountered	from	to
Harvey Stevens Bentonia, Mississippi (mailing address)			
WELL LOCATION:			
sec <u>14</u> T <u>9</u> N R <u>3</u> E 15K 7 miles West Bentonia (distance) (direction) (nearest town)			
WELL PURPOSE: <u>home</u> (home, irrigation, municipal, industrial)			
WELL COMPLETION DATA:			
(1) diameter (inches) <u>2</u>			
(2) total depth (feet) <u>89</u>			
(3) static water level (feet) <u>60</u> below top of ground.			
(4) casing <u>Steel</u> <u>84</u> (material) (depth) <u>2</u> if telescope see back. (size)			
(5) screen <u>5</u> <u>84</u> (length) (depth to top) <u>2</u> <u>Stainless</u> (size) (material)			
(6) pump <u>1</u> <u>8</u> (HP) (yield gpm) <u>0</u> (type power)			
(7) electric log <u>No</u> (yes or no) <u>0</u> (organization running log)			
(8) how well bottom plugged <u>Steel plug</u>			
DRILLERS REMARKS:			

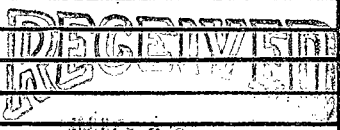

If well telescopes please sketch and show depths.

GROUND LEVEL

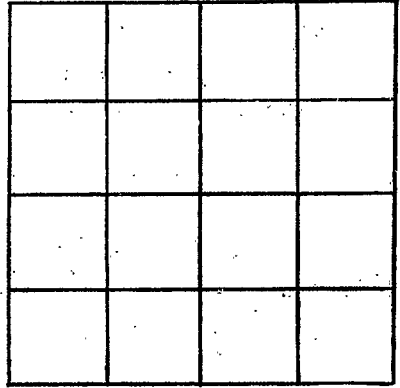

SECTION _____

Please indicate well location X.

ADDITIONAL INFORMATION

If more than one screen, show locations of each on sketch.