

YAZOO
 V41
 10-31-75
 Log #266
 10-31

MISSISSIPPI
 BOARD OF WATER COMMISSIONERS
 416 North State Street
 Jackson, Mississippi 39201

CODED

WATER WELL DRILLERS LOG

date well completed 1975 firm name K.M. "Bud" Creswell county well located Yazoo

LANDOWNER:
 Ruthie Jackson
 Benton, Ms. 39040
 (mailing address)

WELL LOCATION:
 sec. 4 T 9 N R 3 E W
 3 miles N of Mechanicville
 (distance) (direction) (nearest town)

WELL PURPOSE: home
 (home, irrigation, municipal, industrial)

WELL COMPLETION DATA:
 (1) diameter (inches) 4
 (2) total depth (feet) 670
 (3) static water level (feet) 210 below top of ground.
 (4) casing Steel 650 (material) (depth)
 4 (size) if telescope see back.
 (5) screen 20 650 (length) (depth to top)
 2 stainless (size) (material)
 (6) pump 1 10 (HP) (yield gpm)
 0 (type power)
 (7) electric log yes
 Miss State LRS (organization running log)

(8) how well bottom plugged
 steel plug

description of formations encountered	from	to
Clay	0	60
Sand - gravel	60	95
Clay	95	380
Sand, Shells	380	410
Shale	410	440
Sand	440	480
Coarse shale	480	555
Shale	555	620
Sand	620	670


CODED

NOV 11 1975

DRILLERS REMARKS:

If well telescopes please sketch and show depths.

GROUND LEVEL

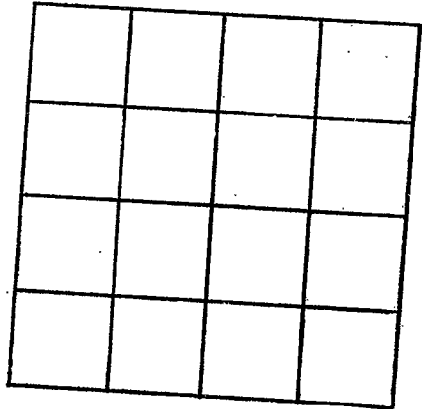

SECTION _____

Please indicate well location X.

ADDITIONAL INFORMATION

If more than one screen,
show locations of each on sketch.