

V4200
 V42
 1-30-76
 Elcraft #268
 1-30L

MISSISSIPPI
 BOARD OF WATER COMMISSIONERS
 416 North State Street
 Jackson, Mississippi 39201

CODED

WATER WELL DRILLERS LOG

date well completed 1976 September Drilling Co. Yazoo firm name Yazoo county well located

LANDOWNER:
L B Entle
~~Battle on elec~~
 (mailing address) log

description of formations encountered	from	to
Clay	0	90
Shale Rock	90	160
Clay	160	200
Sand	200	230
		TD

WELL LOCATION:
 sec. 8 T. 8 N. R. 3 W.
3 1/2 miles East of Phenix
 (distance) (direction) (nearest town)

WELL PURPOSE: home
 (home, irrigation, municipal, industrial)

WELL COMPLETION DATA:
 (1) diameter (inches) 2"
 (2) total depth (feet) 230
 (3) static water level (feet) 160 below above top of ground.
 (4) casing PVC 230
 (material) (depth)
 if telescope see back.
 (size)
 (5) screen 12 218
 (length) (depth to top)
2" PVC
 (size) (material)
 (6) pump 1 1/2 10
 (HP) (yield gpm)
AC
 (type power)
 (7) electric log yes
 (yes or no)
M.S.
 (organization running log)
 (8) how well bottom plugged back wash valve


CODED

RECEIVED
 MAR 20 1976

DRILLERS REMARKS:

If well telescopes please
sketch and show depths.

GROUND LEVEL

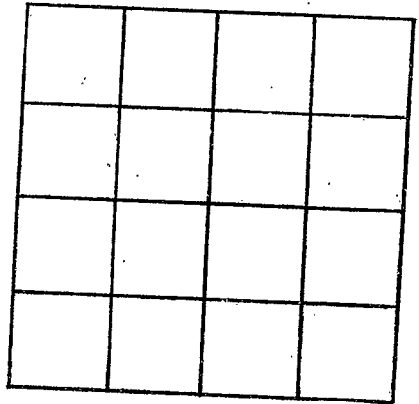

SECTION _____

Please indicate well location X.

ADDITIONAL INFORMATION

If more than one screen,
show locations of each on sketch.