

YAZOO  
 V43  
 4-21-76  
 ELG # 269  
 4/21/76

MISSISSIPPI  
 BOARD OF WATER COMMISSIONERS  
 416 North State Street  
 Jackson, Mississippi 39201

CODED

WATER WELL DRILLERS LOG

E.M. "Bud" CRESSWELL YAZOO  
 date well completed firm name county well located

LANDOWNER:  
 CAROL McGRAW  
 BENTONIA, MS.  
 (mailing address)

description of formations encountered	from	to
Clay	0	50
Sand-gravel	50	65
Clay	65	100
Sand	100	165
Clay	165	195

WELL LOCATION:  
 sec 10 T 8 N R 3  
 8 miles West of BENTONIA  
 (distance) (direction) (nearest town)

WELL PURPOSE: home  
 (home, irrigation, municipal, industrial)

CODED


- WELL COMPLETION DATA:
- (1) diameter (inches) 2
  - (2) total depth (feet) 168
  - (3) static water level (feet) 80 below top of ground.
  - (4) casing Steel, 148,  
 (material) (depth)  
2 if telescope see back.  
 (size)
  - (5) screen 20, 148  
 (length) (depth to top)  
2, STAINLESS  
 (size) (material)
  - (6) pump 1, 5  
 (HP) (yield gpm)  
0  
 (type power)
  - (7) electric log Yes  
 (yes or no)  
State  
 (organization running log)
  - (8) how well bottom plugged  
Steel plug

DRILLERS REMARKS:

DRILLER'S SIGNATURE  
 MAY 12 1976

If well telescopes please sketch and show depths.

GROUND LEVEL

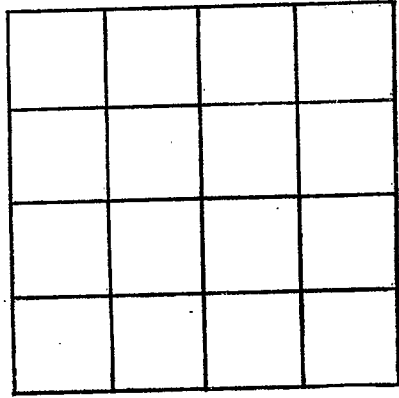

SECTION \_\_\_\_\_

Please indicate well location X.

ADDITIONAL INFORMATION

If more than one screen, show locations of each on sketch.